




As Approved Upper Ground Floor Level - PA 7607 / 07
Scale 1:100

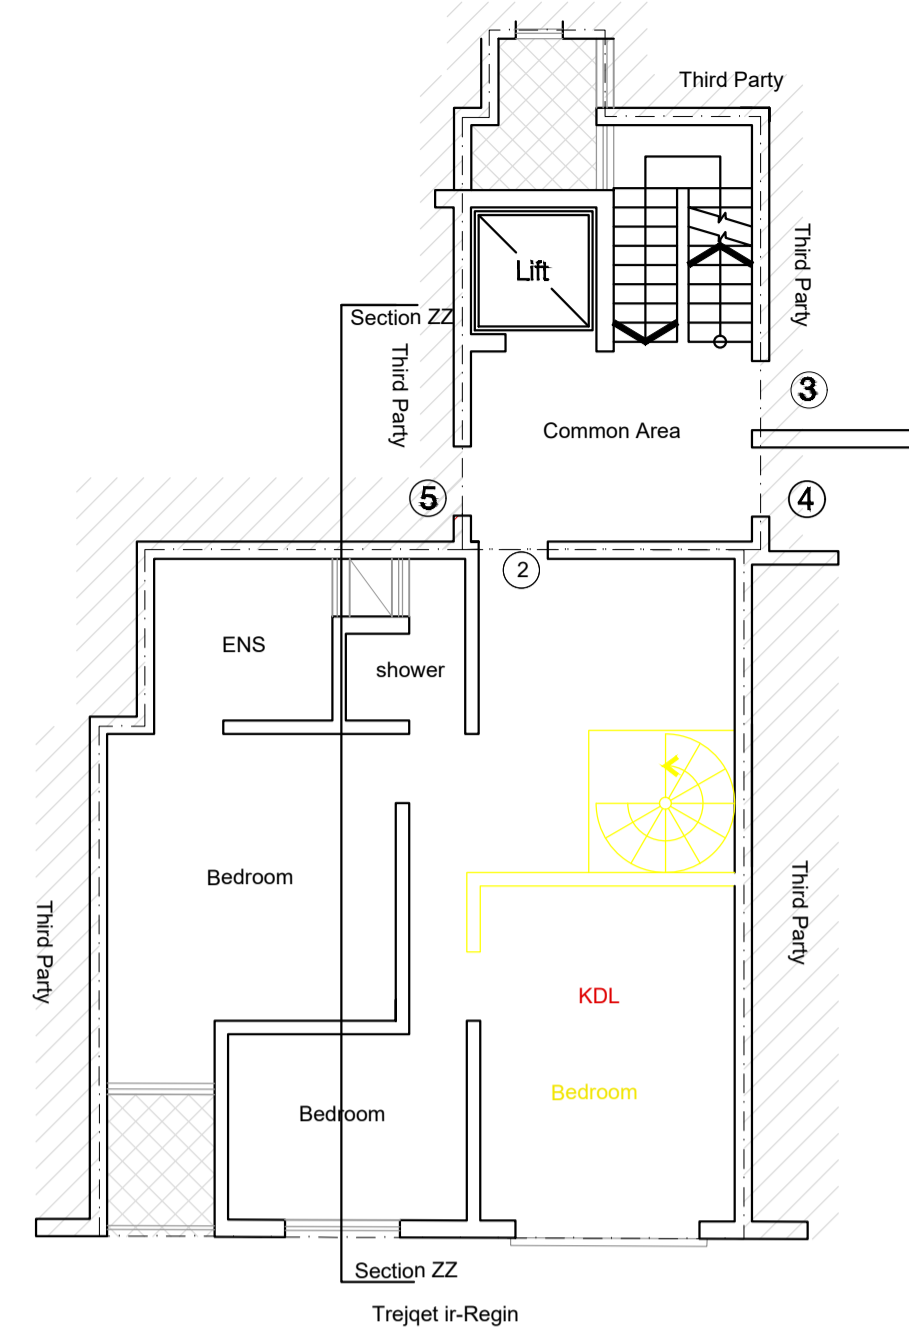


Proposed Upper Ground Floor Level - Conventional Colors
Scale 1:100

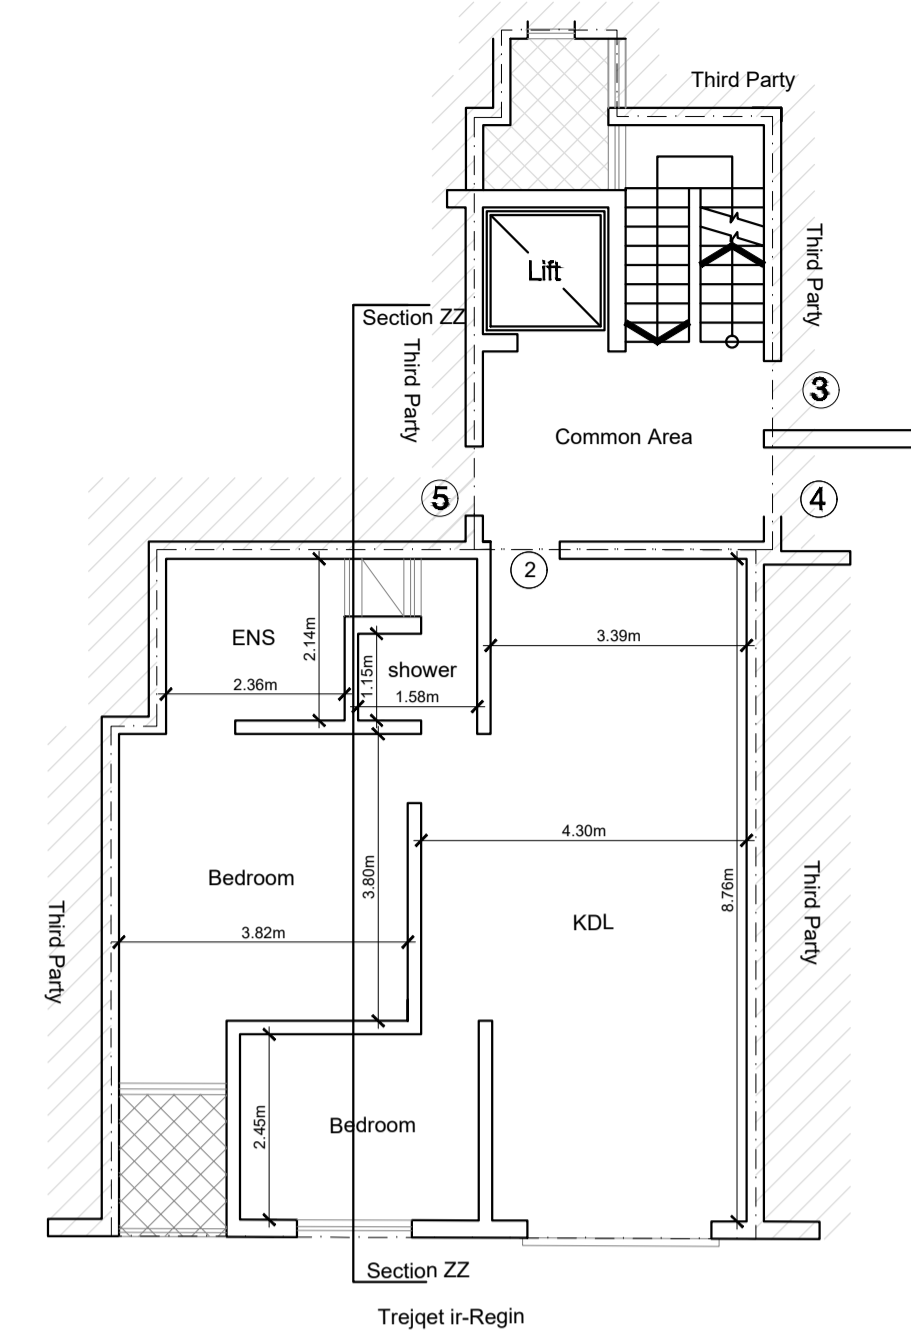


Proposed Upper Ground Floor Level
Scale 1:100
Internal area - 76.21sm

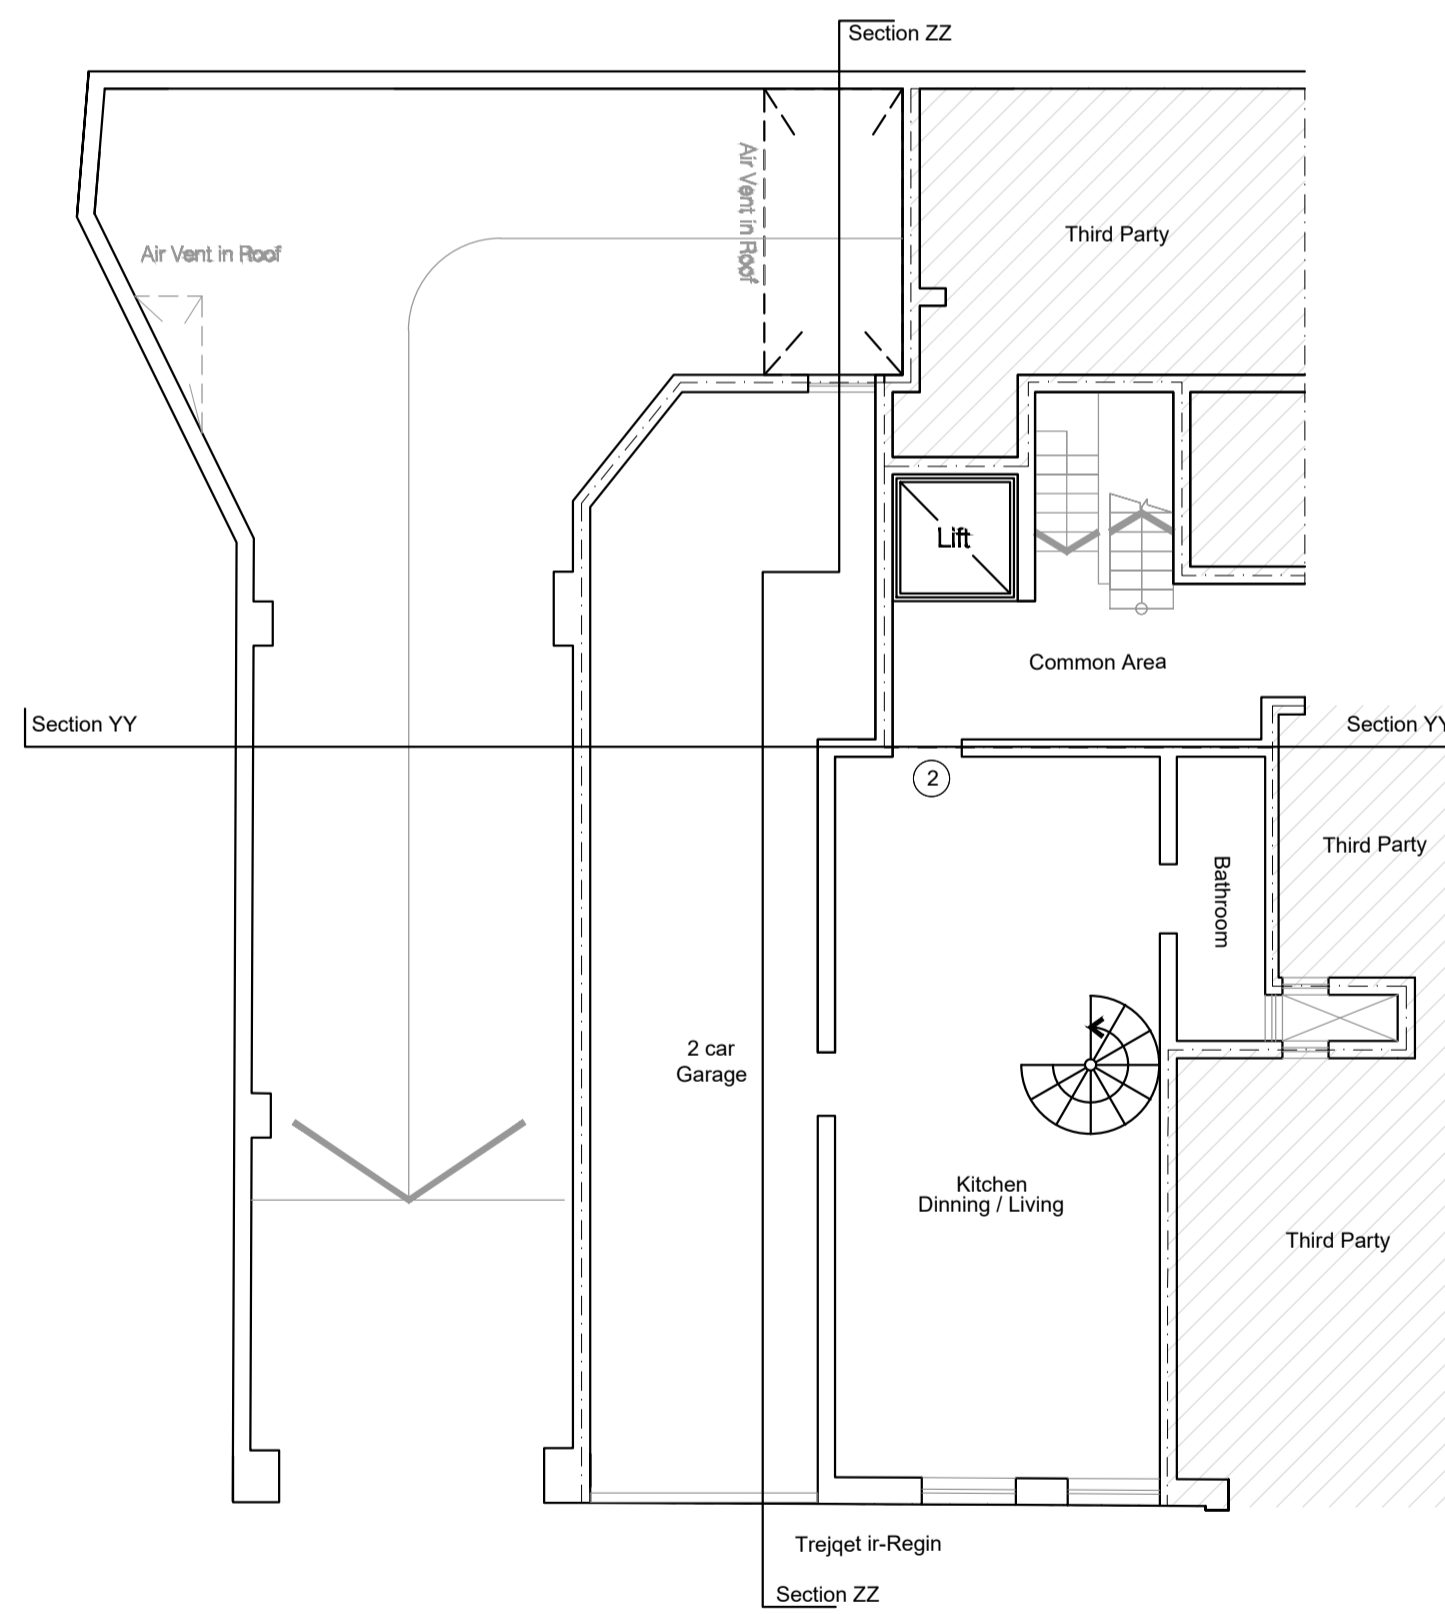

As Approved Lower Ground Floor Level - PA 7607 / 07
Scale 1:100

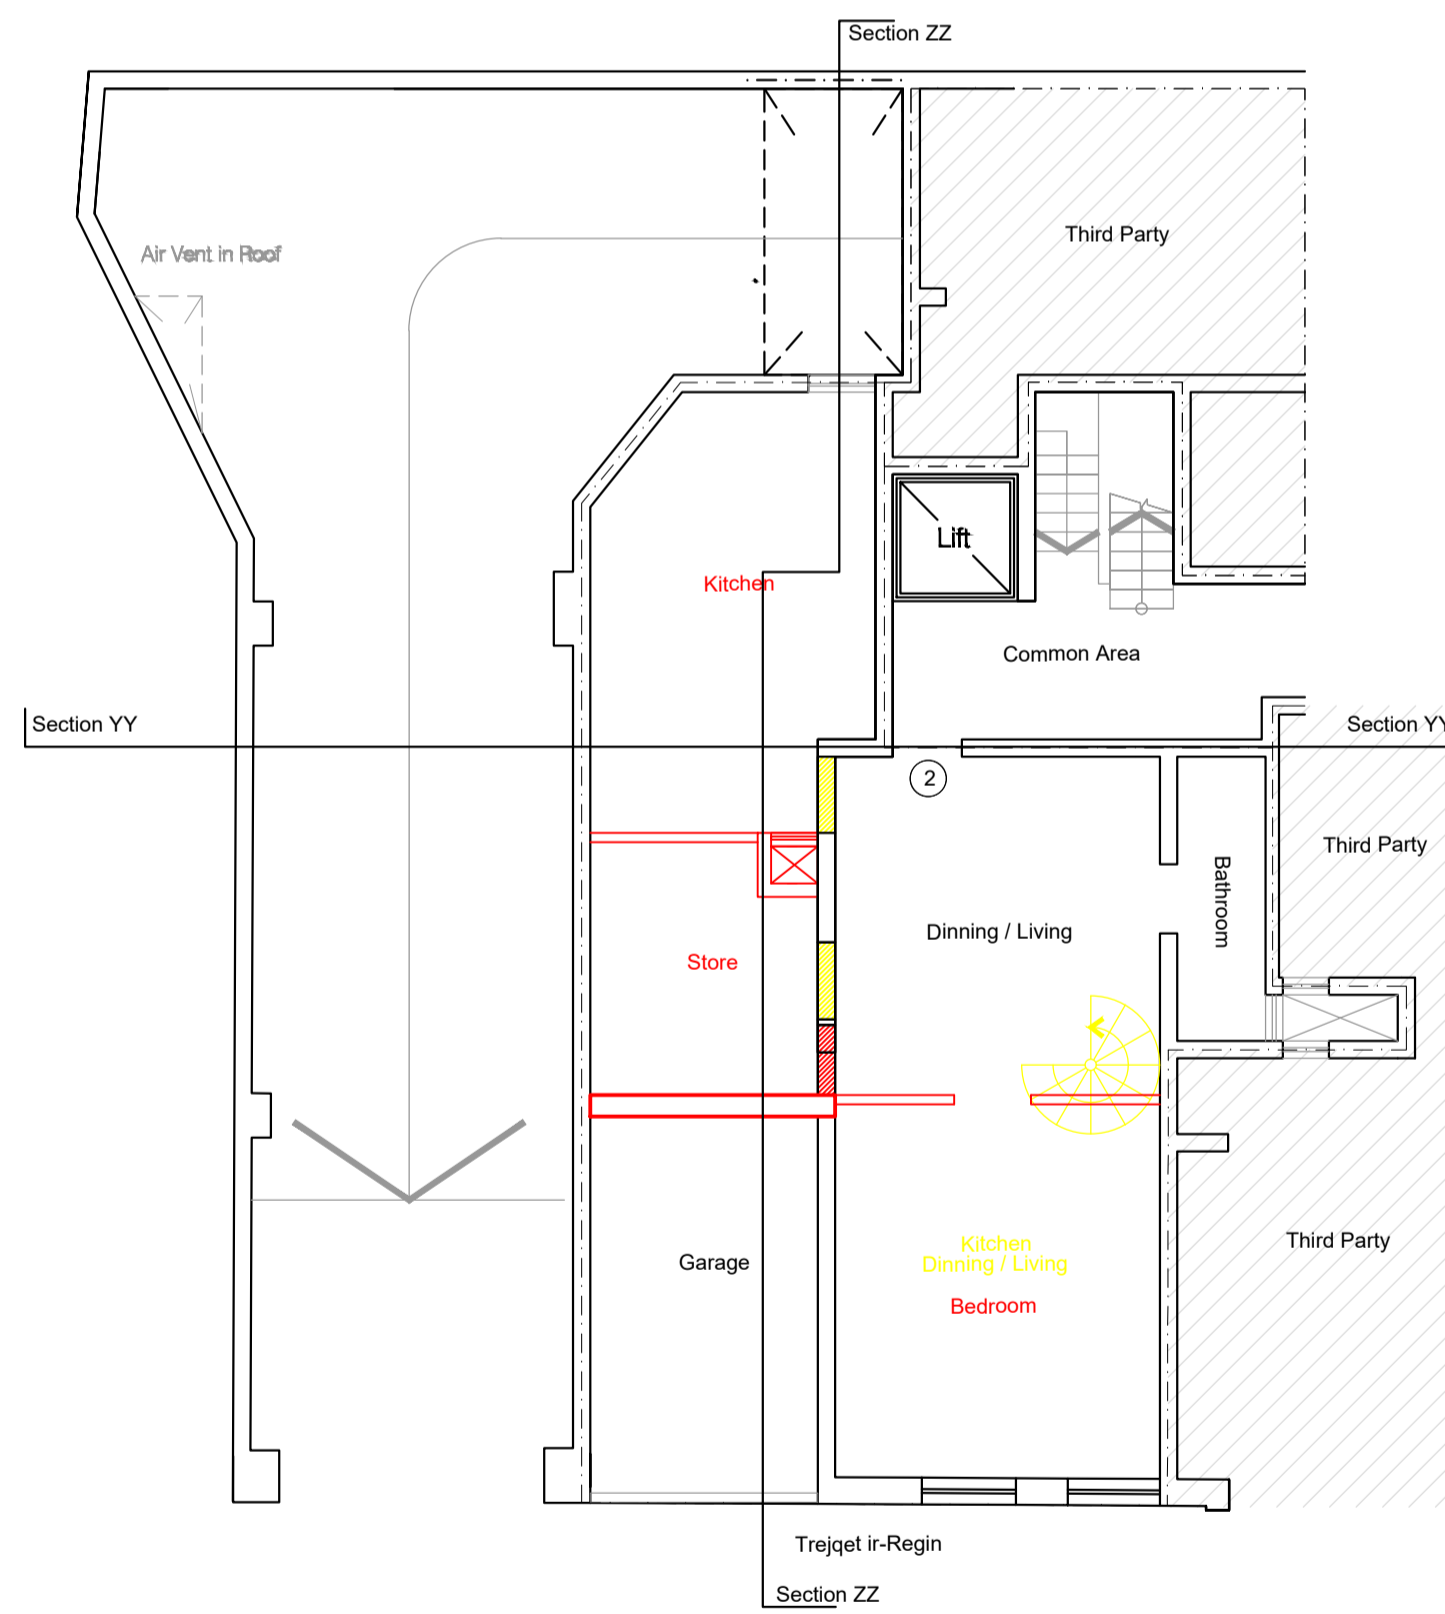

Proposed Lower Ground Floor Level - Conventional Colors
Scale 1:100

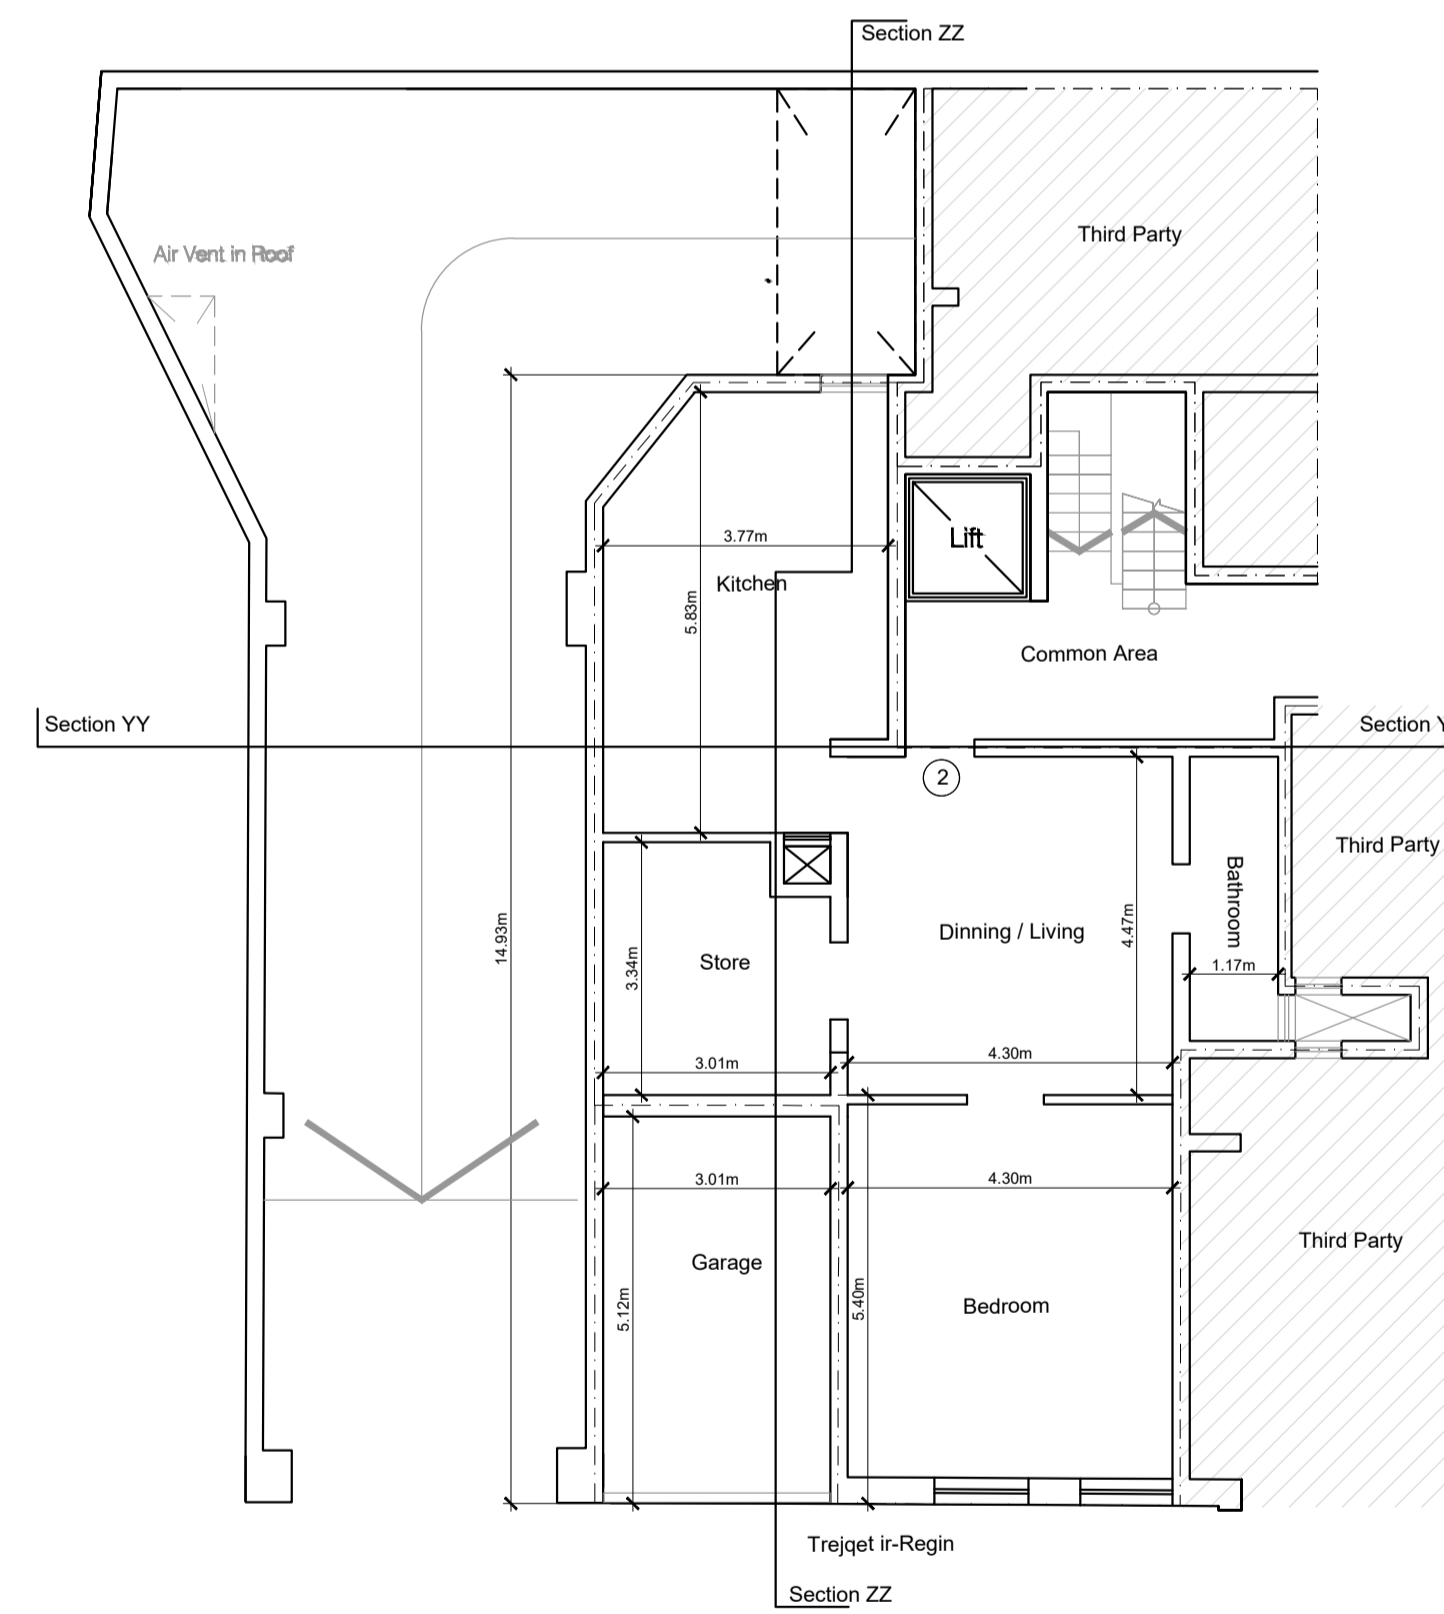

Proposed Lower Ground Floor Level
Scale 1:100
APT Internal area - 84.48sm
Garage - Internal area - 16.9sm

Conventional Color Coding

- Red To construct
- Yellow To demolish
- Blue As built - To surrender
- Green As approved but not constructed

Client: Andrew Vassallo
 Project: Altard
 Scale: 1:100
 Date of first issue: 16.03.24
 Title: Plans
 Dwg No: 001



PERIT GLENN ZAMMIT
 S. E. A. (1996) J. H. B. E. (2001)
 ARCHITECTS & CIVIL ENGINEERS
 99/276A 1/2
 St. George's Road