


Approved Ground Floor  
Scale 1:100




TRIQ SAN GORG

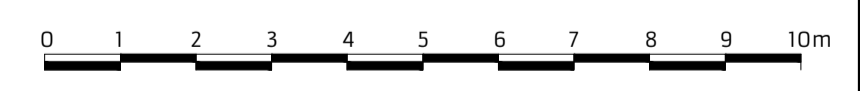

UNNAMED ROAD

As built Level 0  
 Scale 1:100

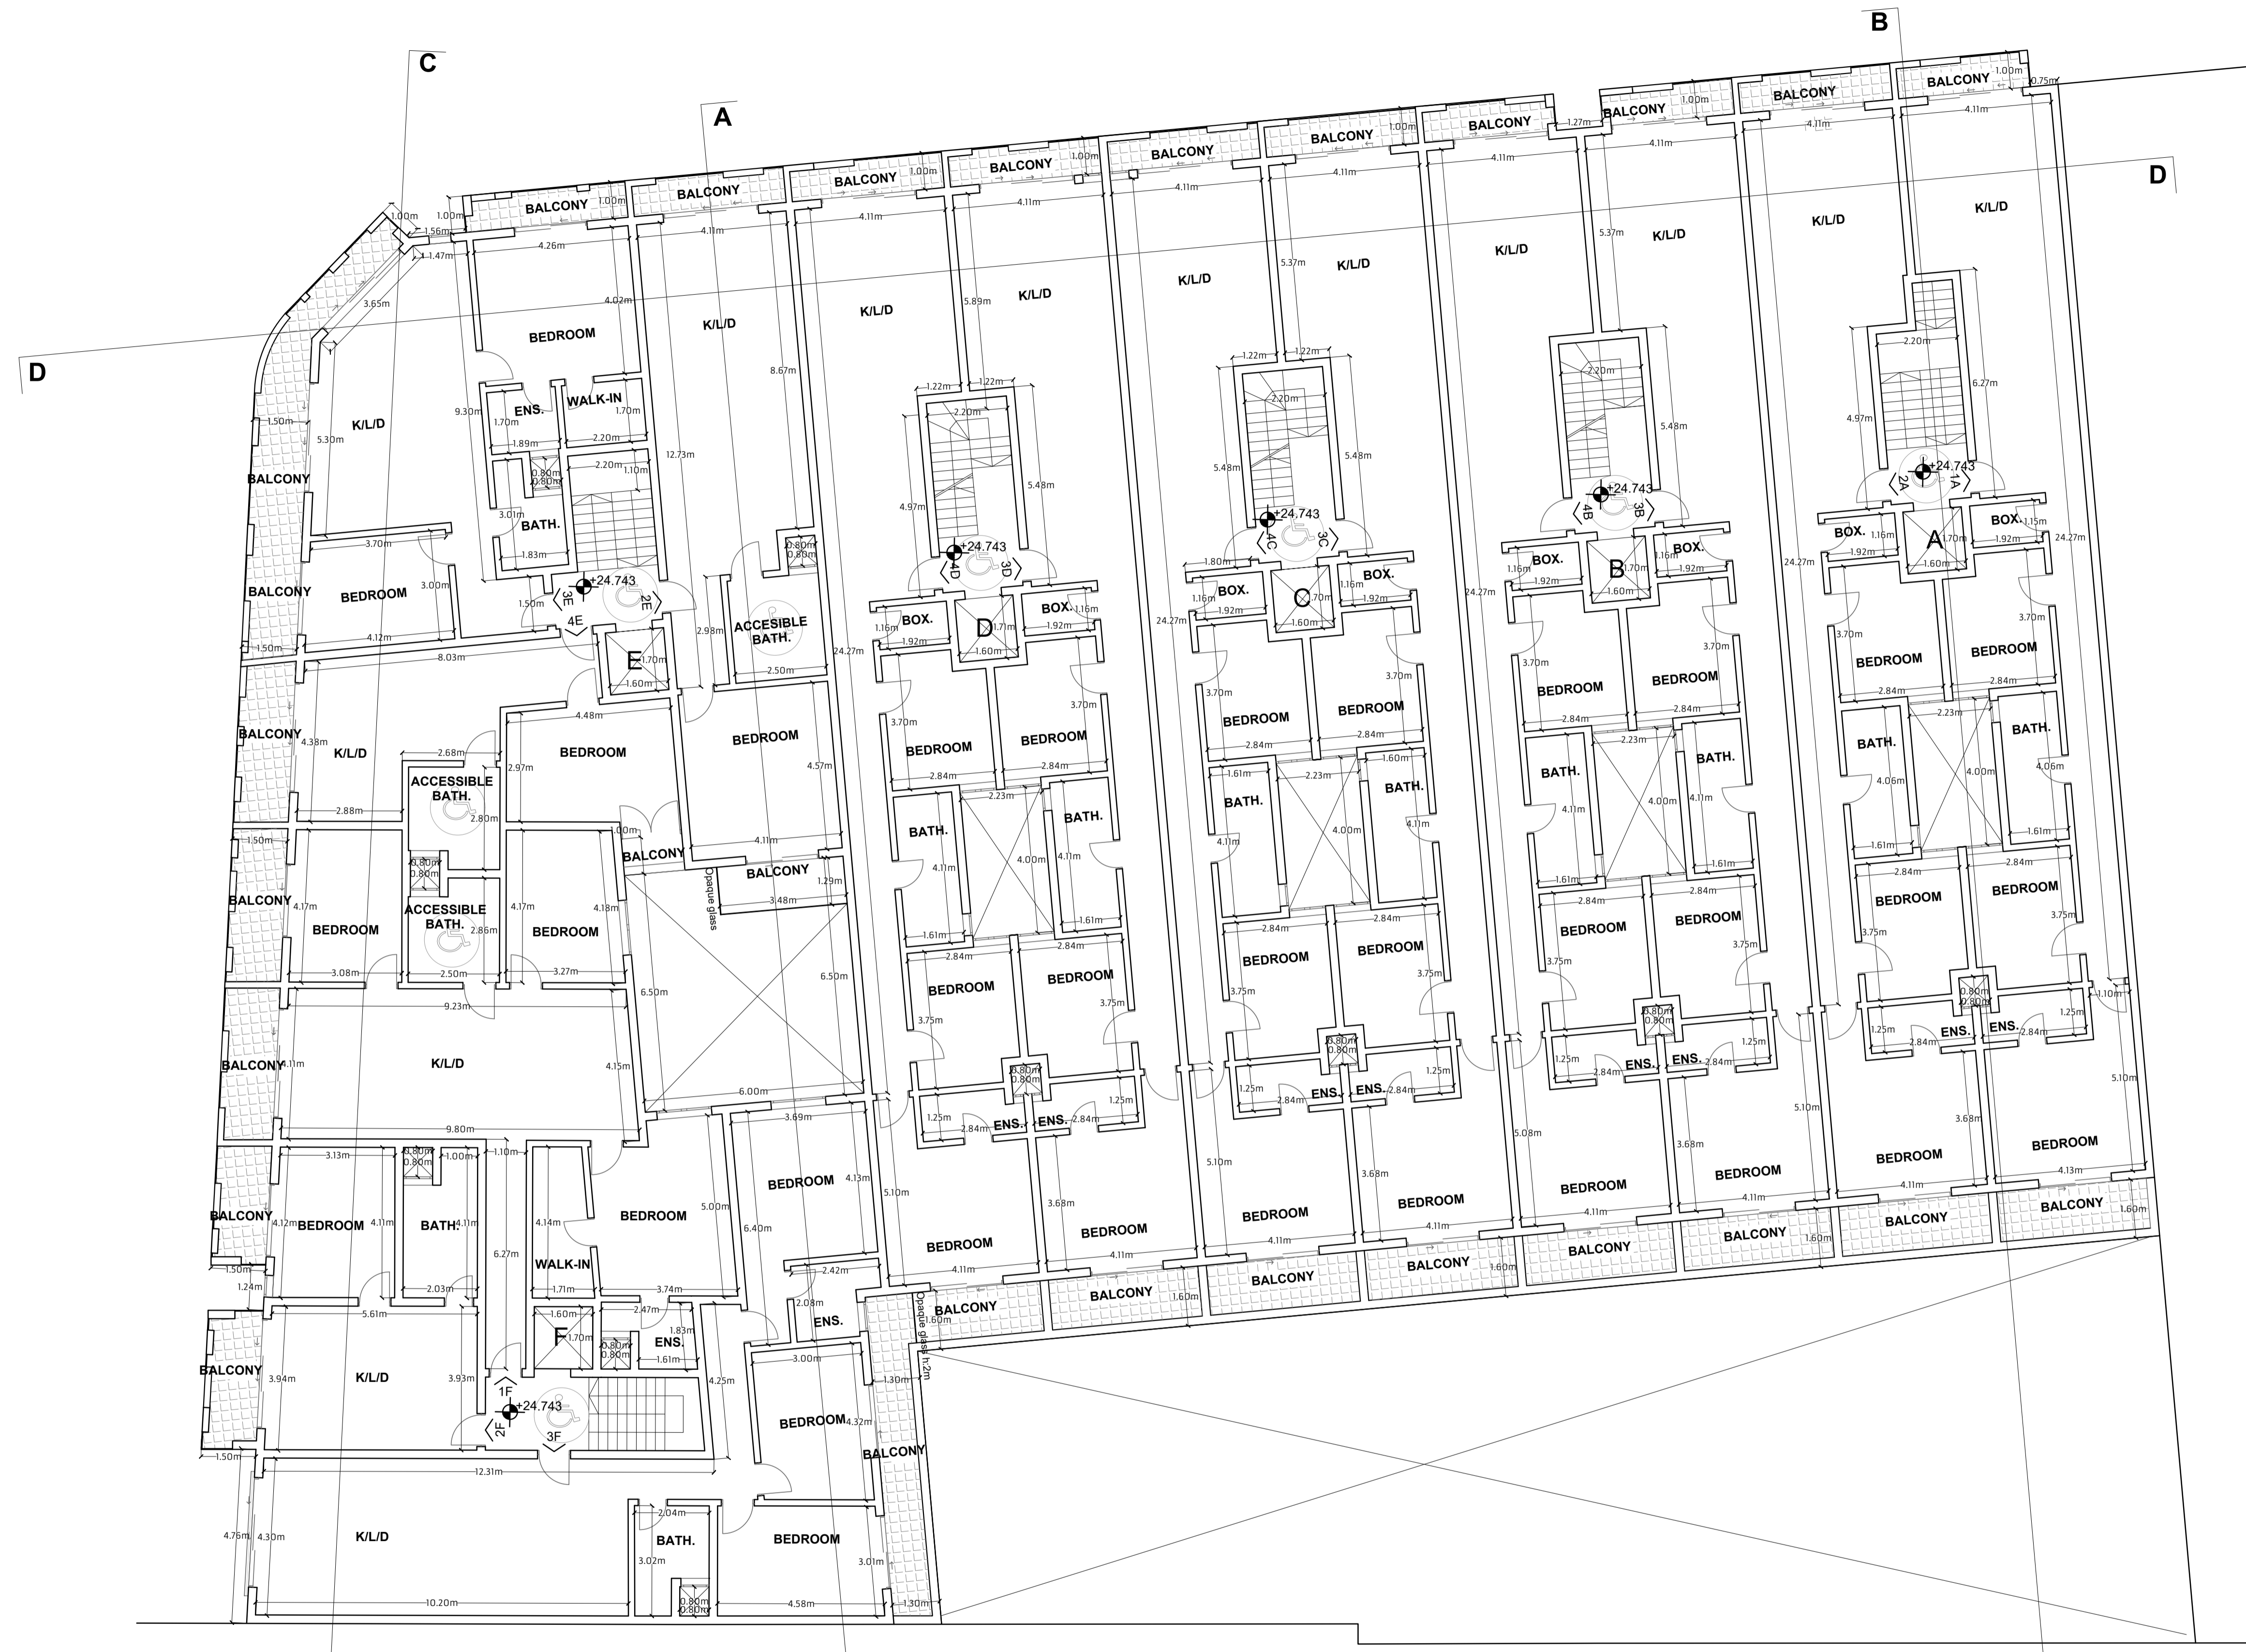

○ Approved 1st Floor


C

A


B




Approved 2nd Floor  
Scale 1:100

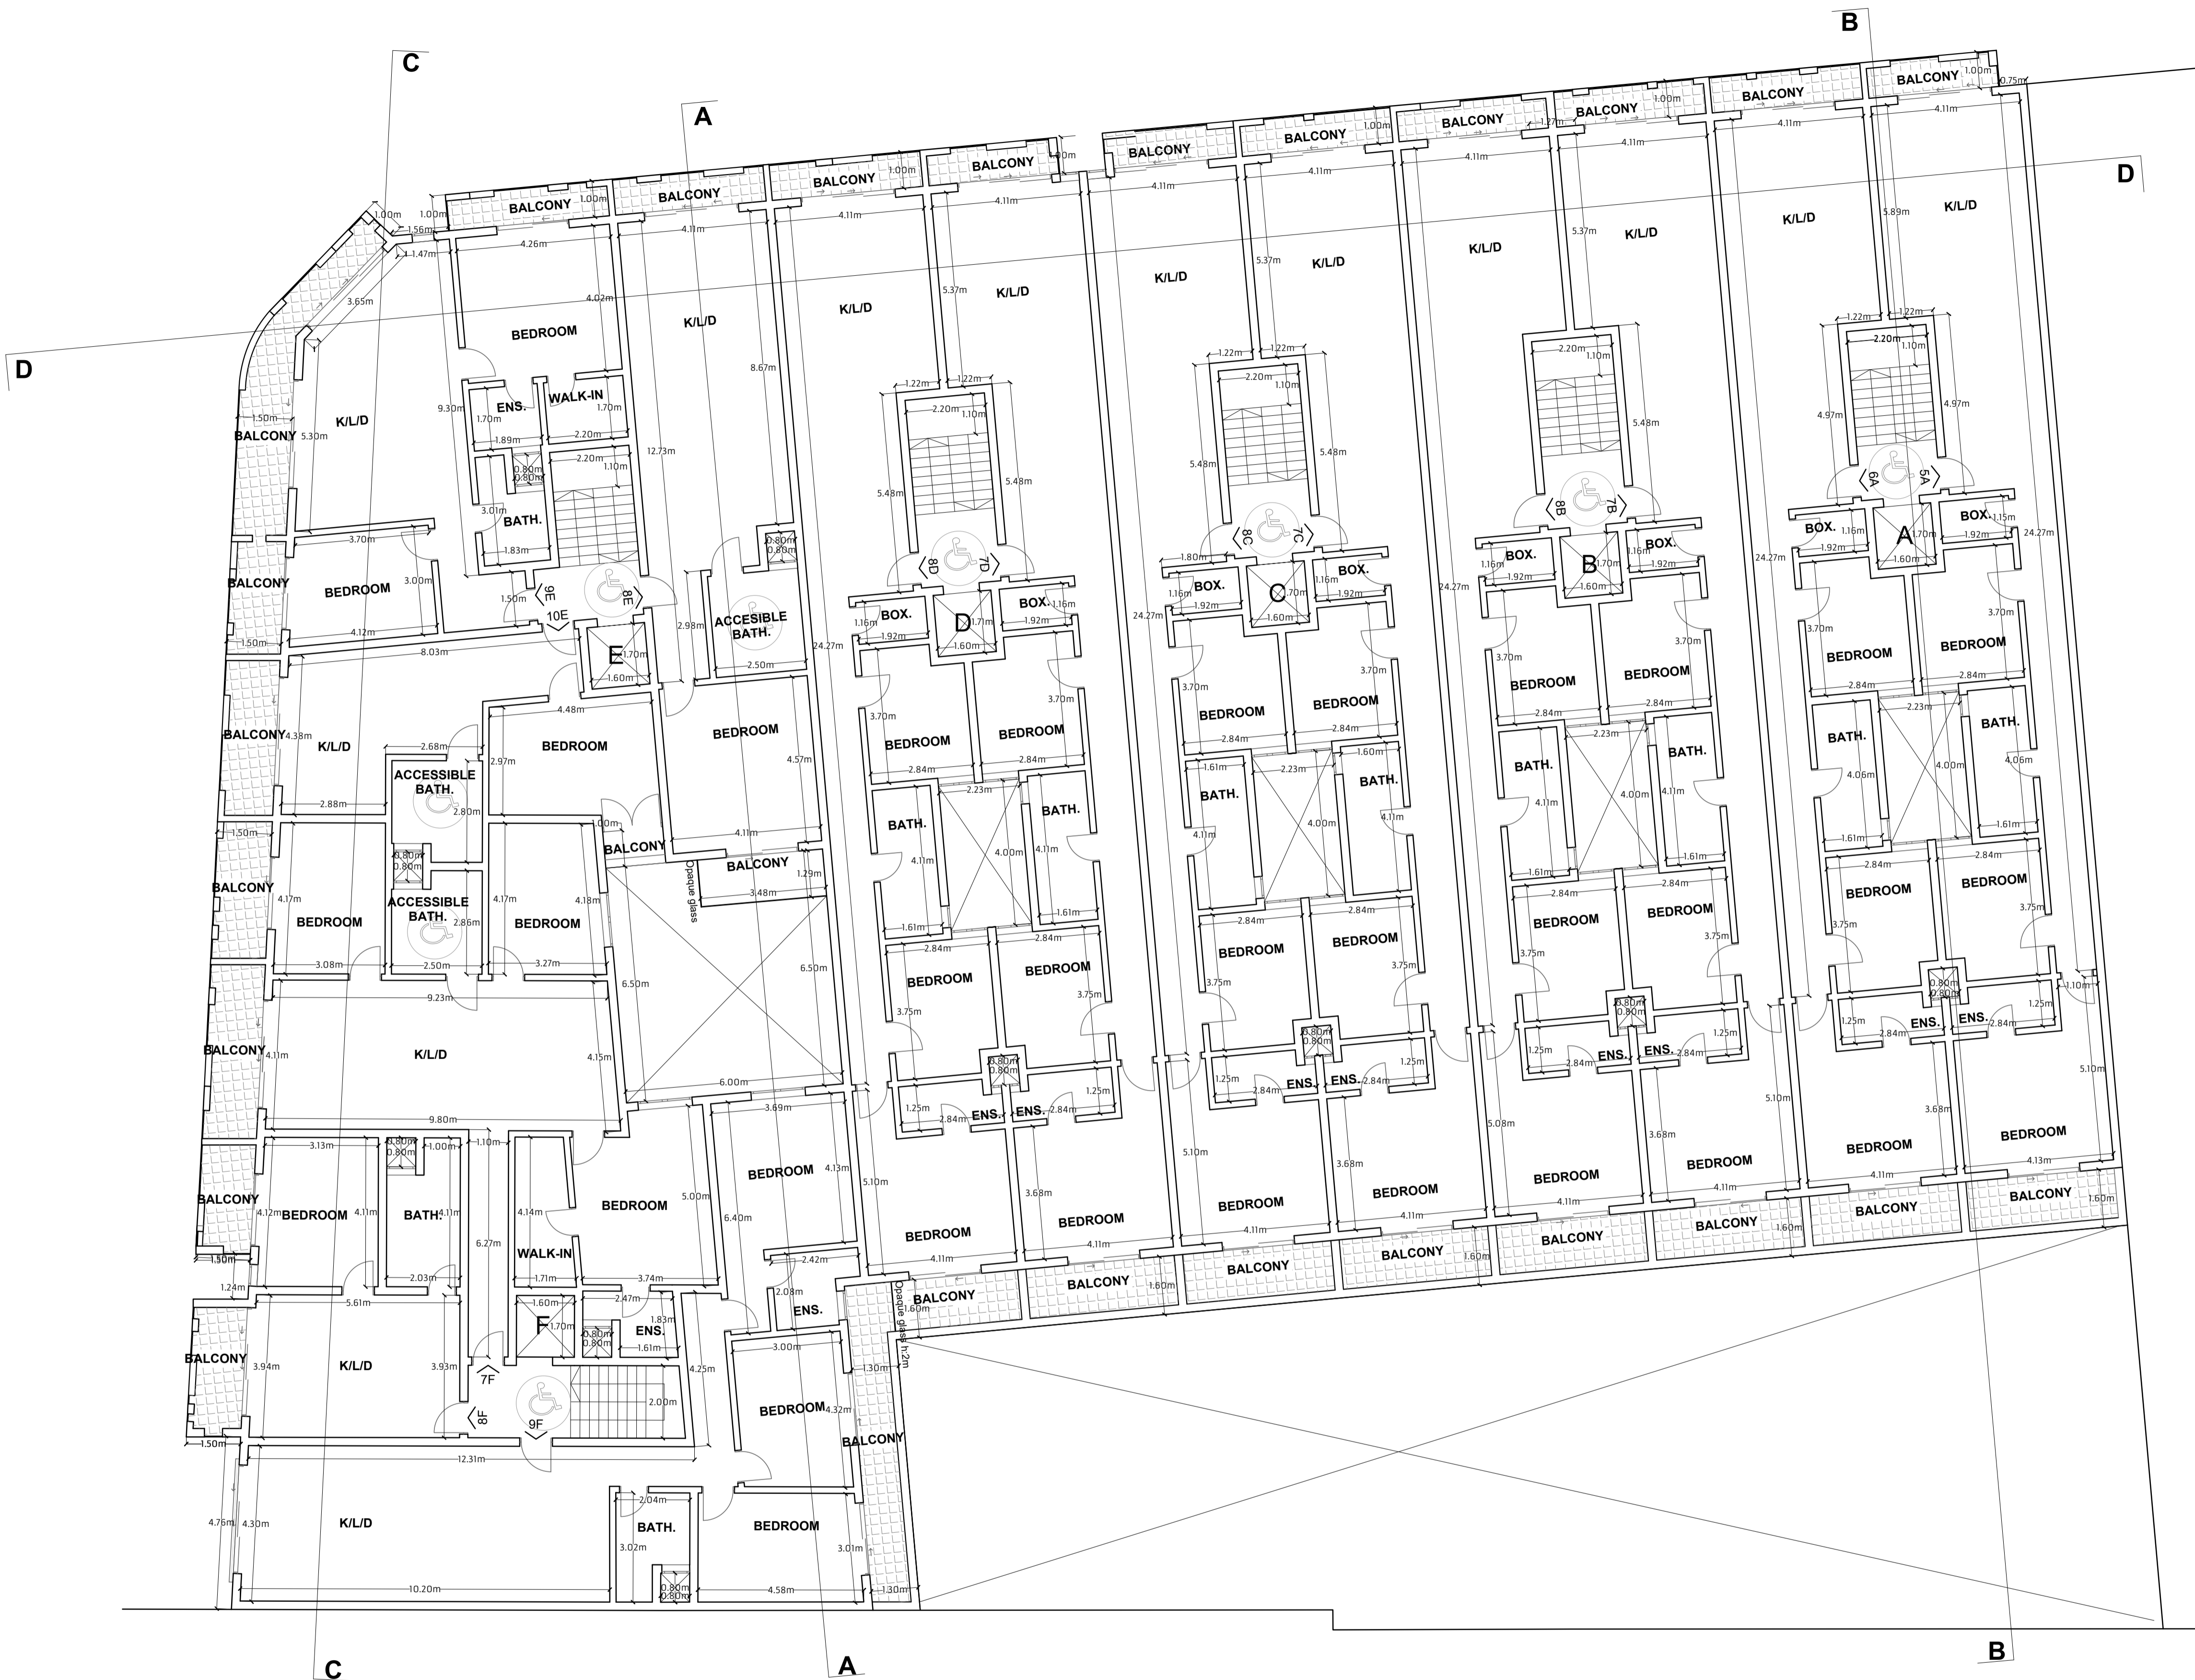



**Approved 3rd Floor**  
 Scale 1:100

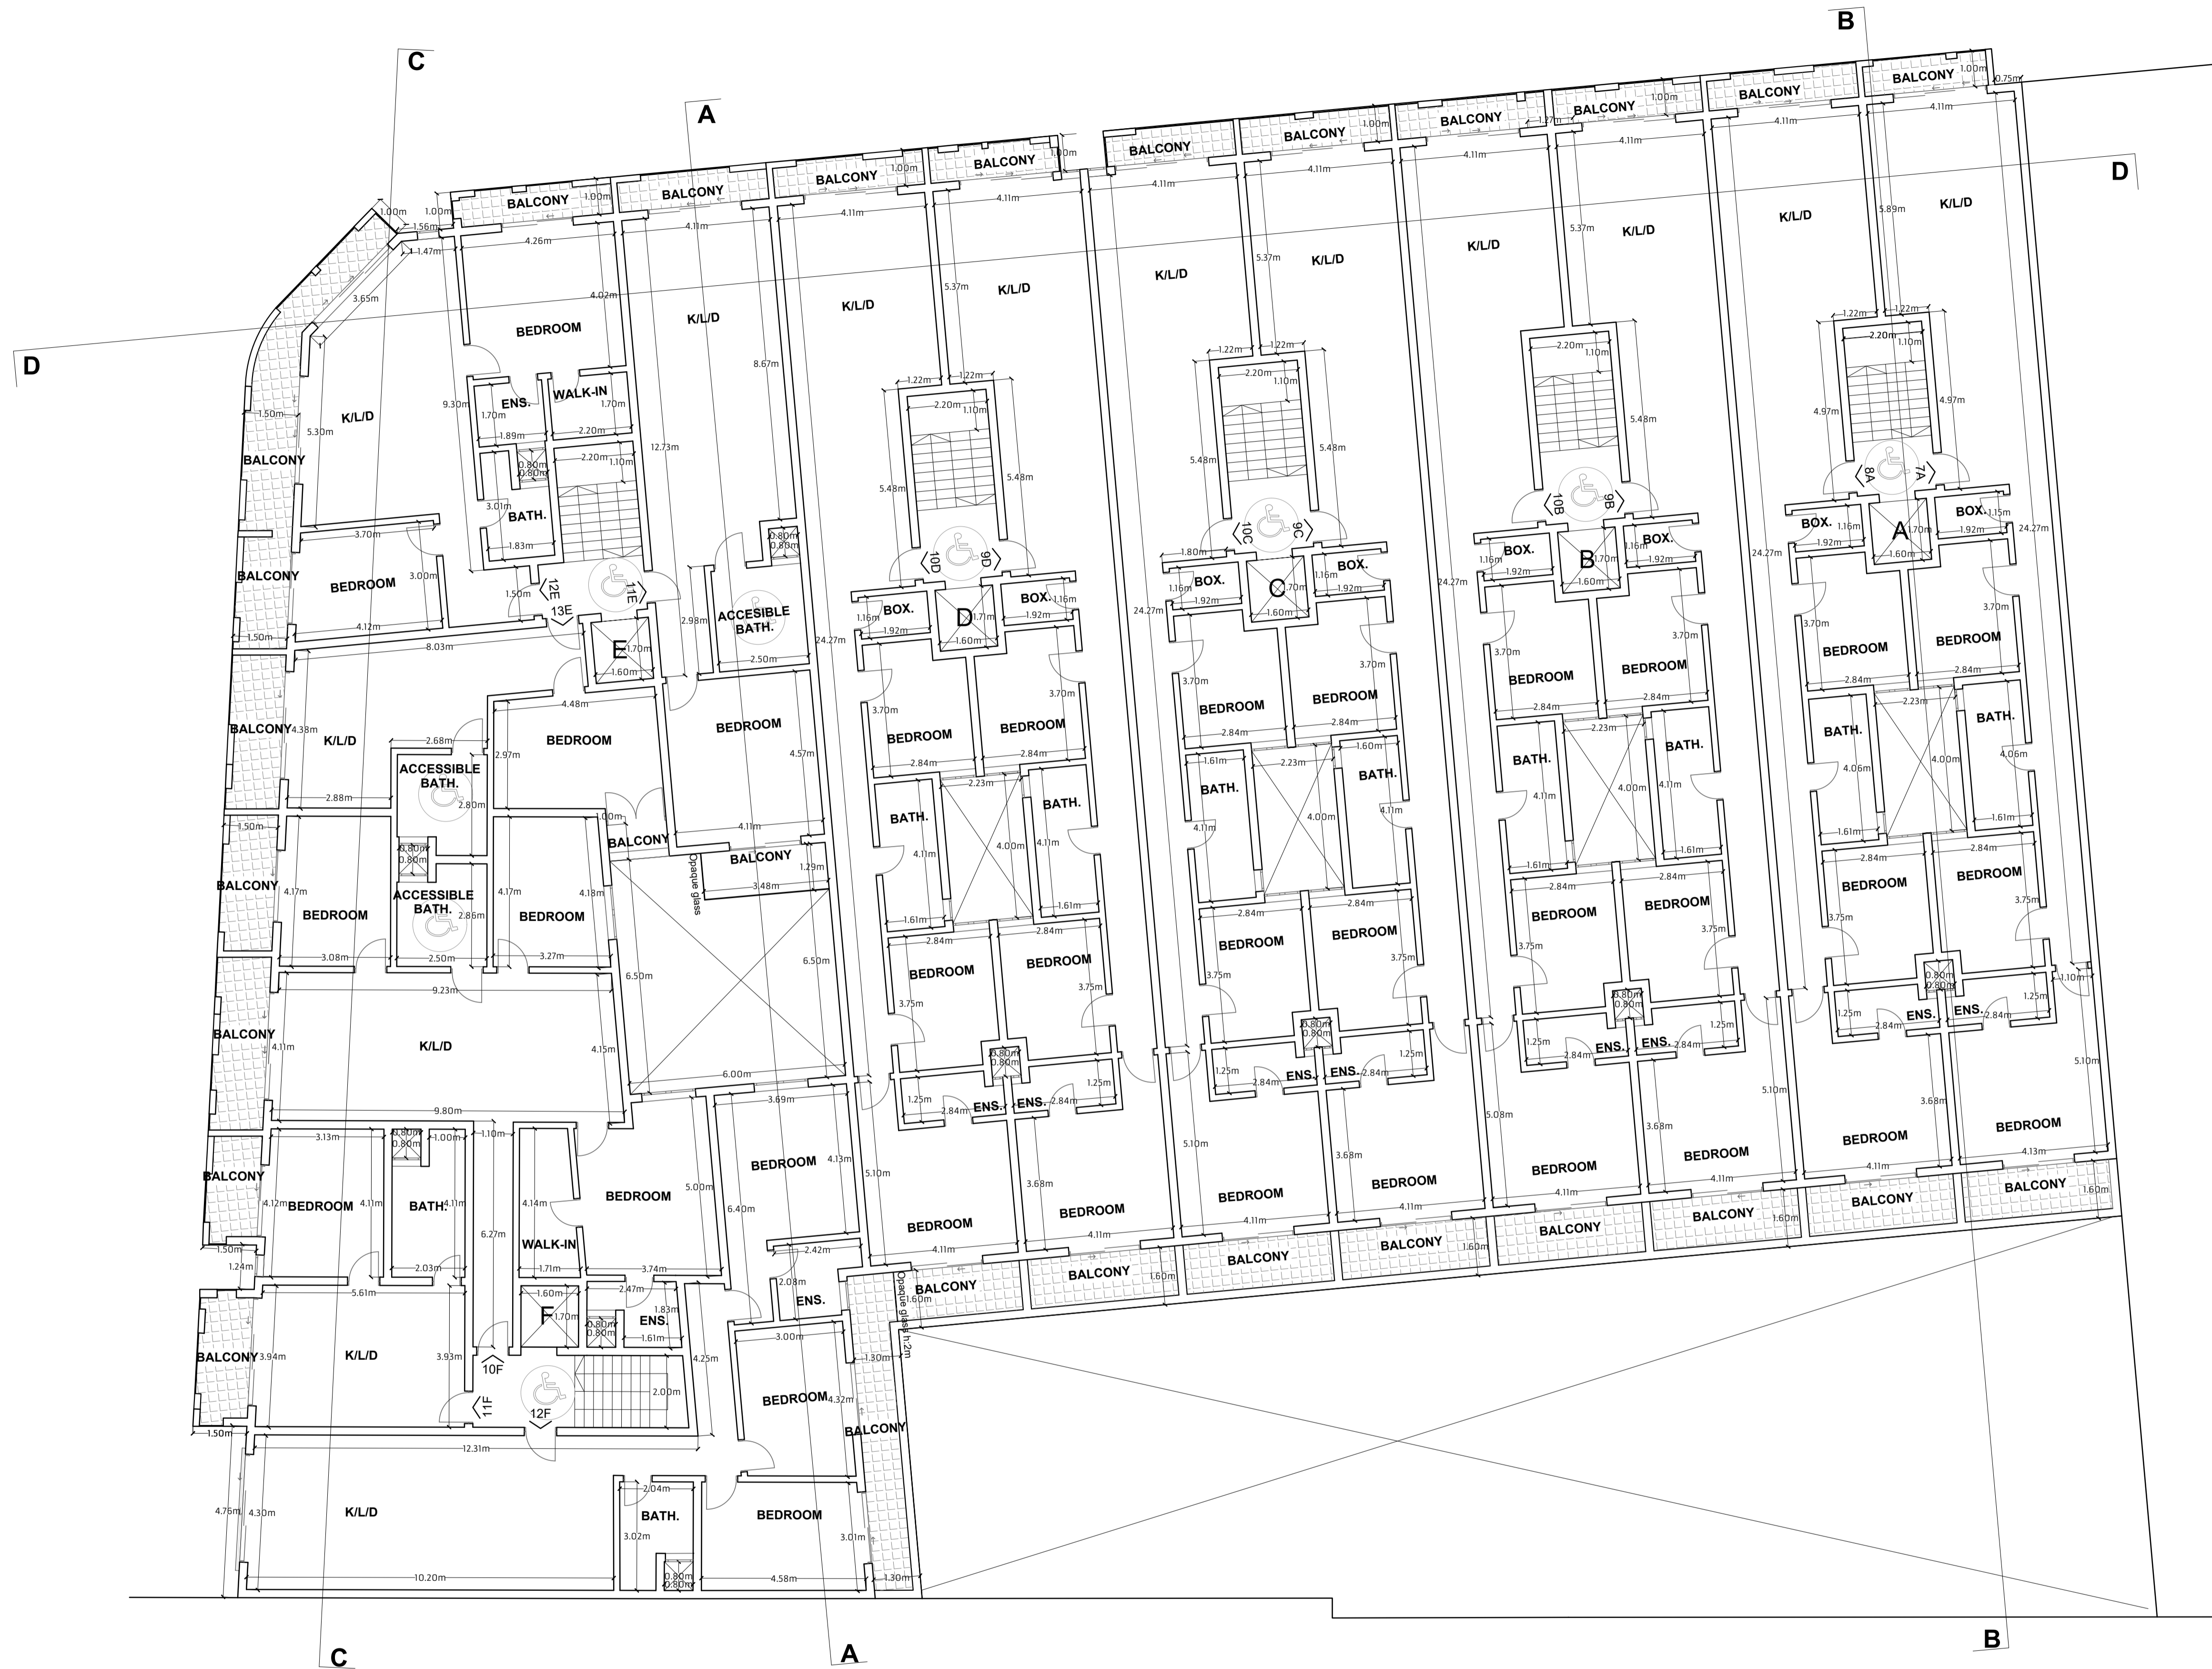


Approved 4th Floor  
Scale 1:100

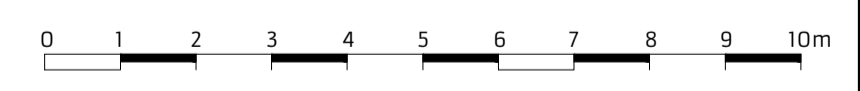


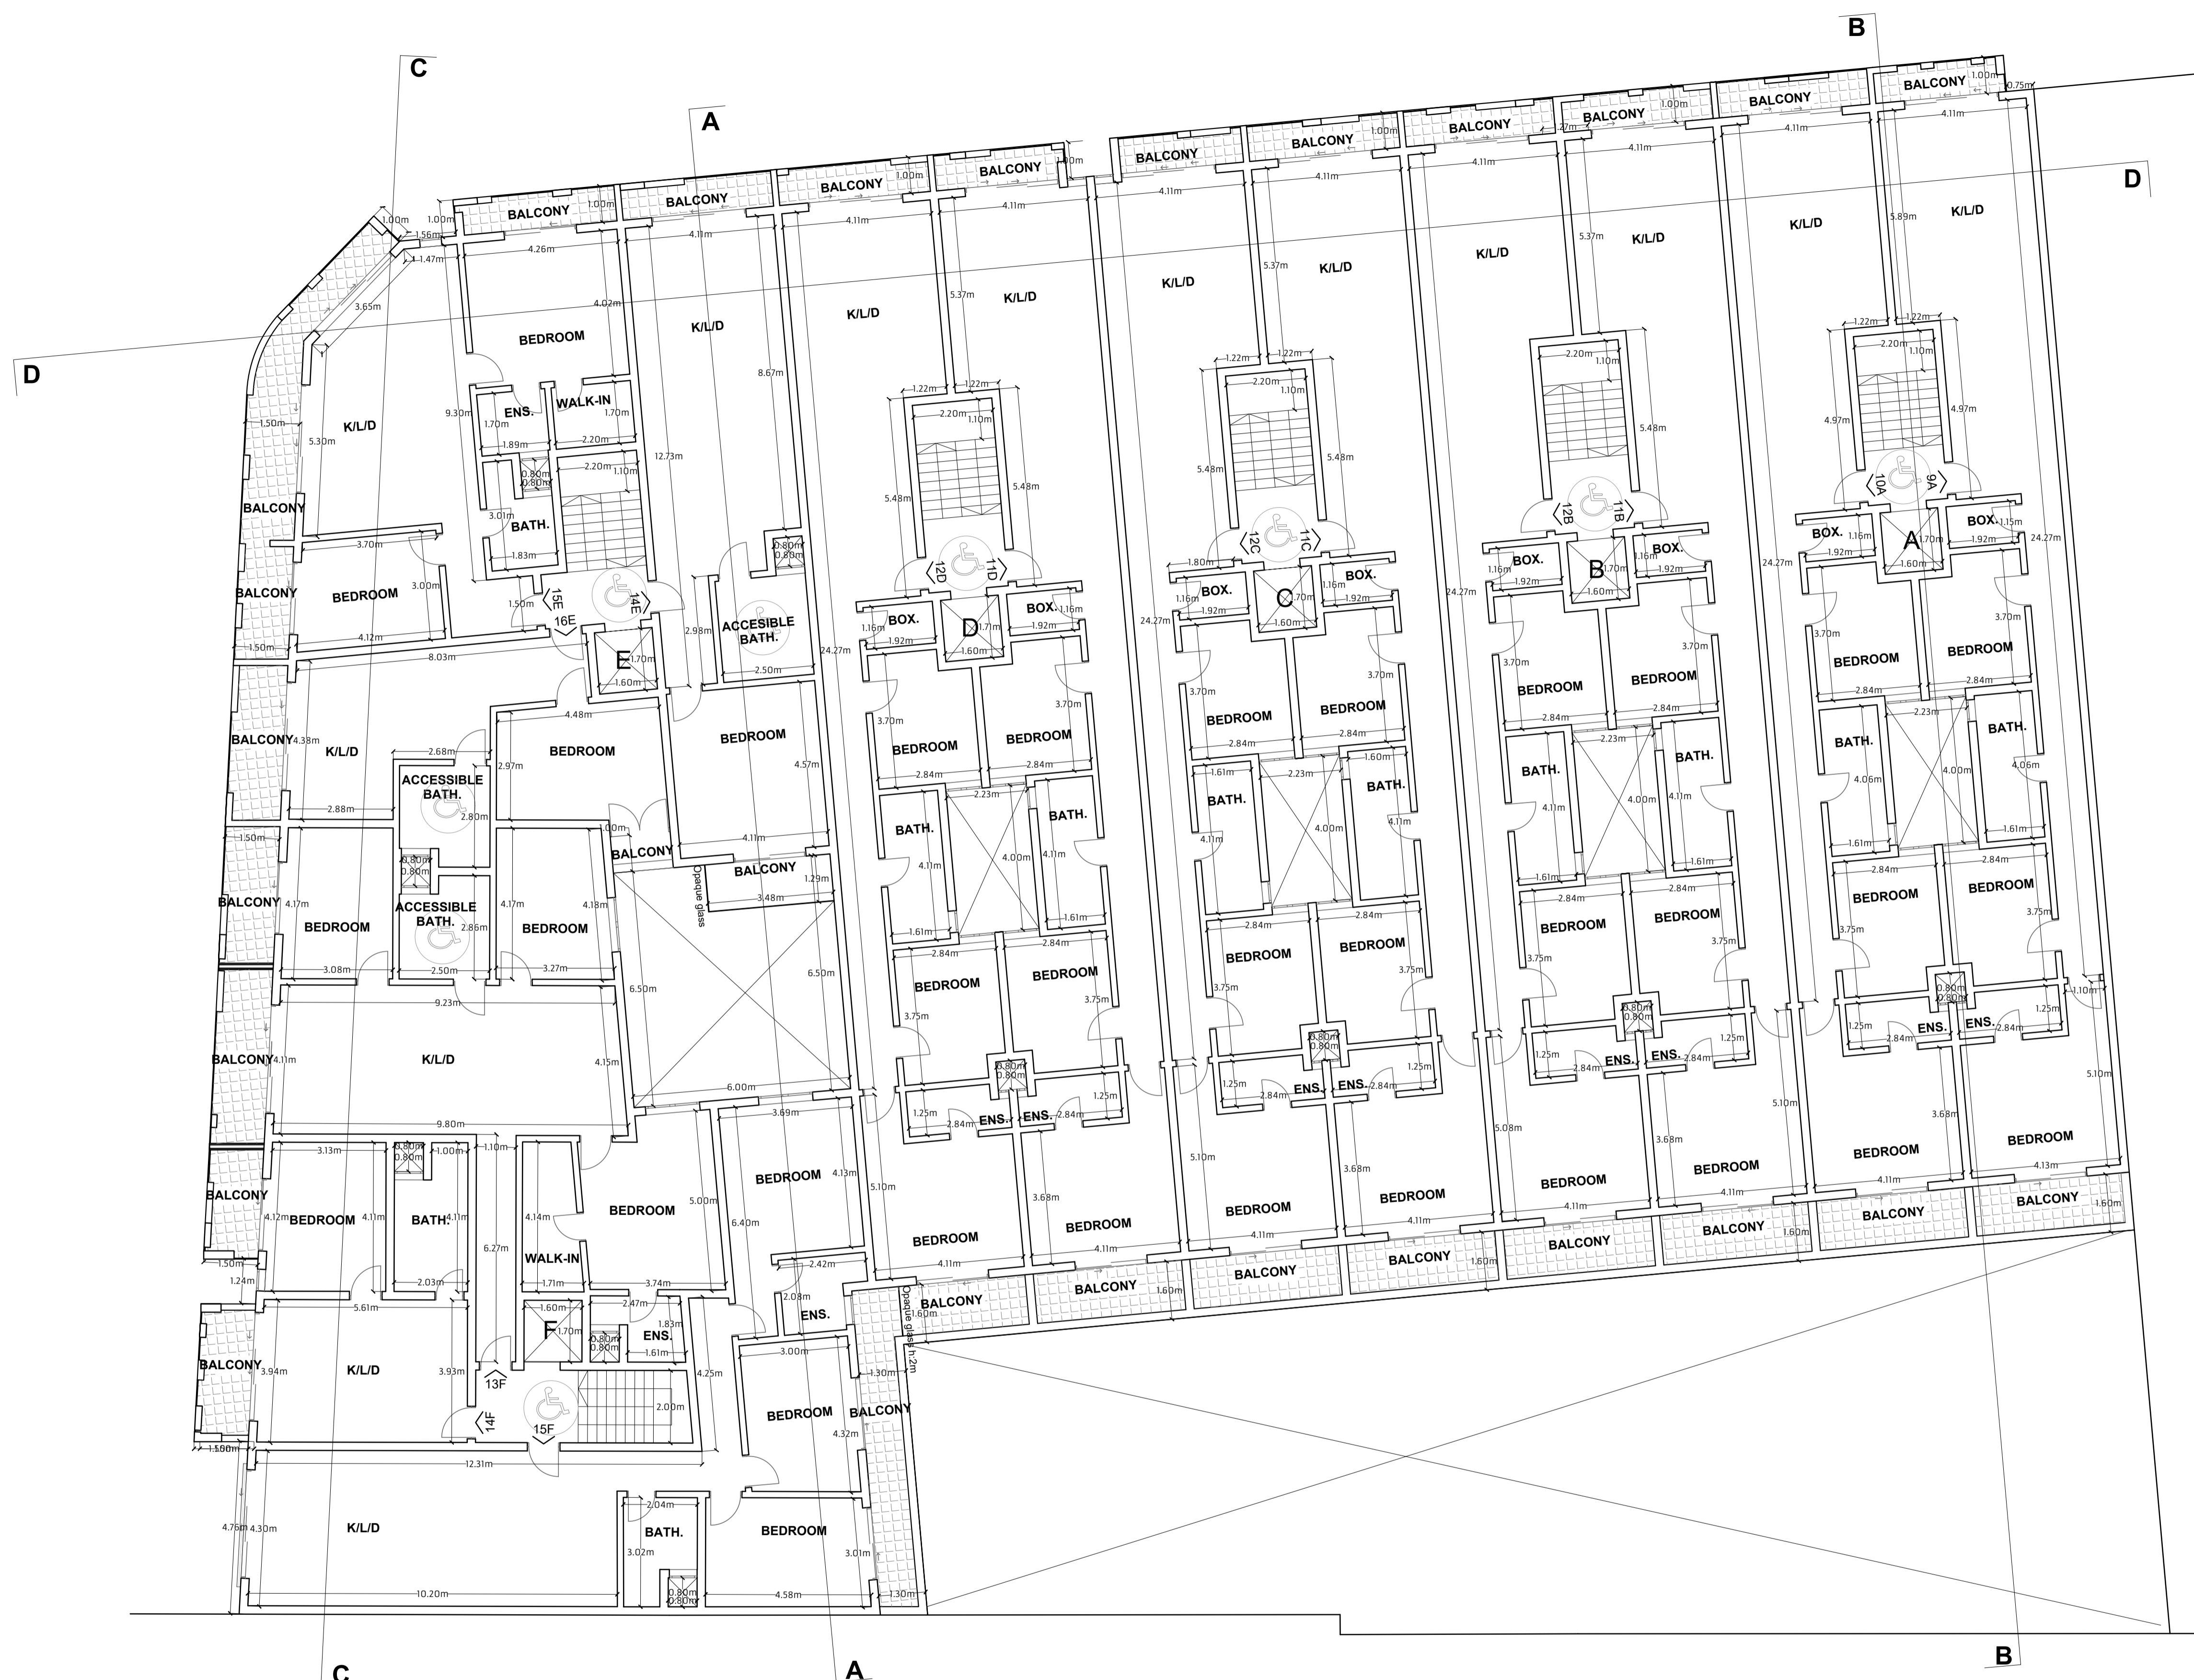

Approved 5th Floor  
Scale 1:100

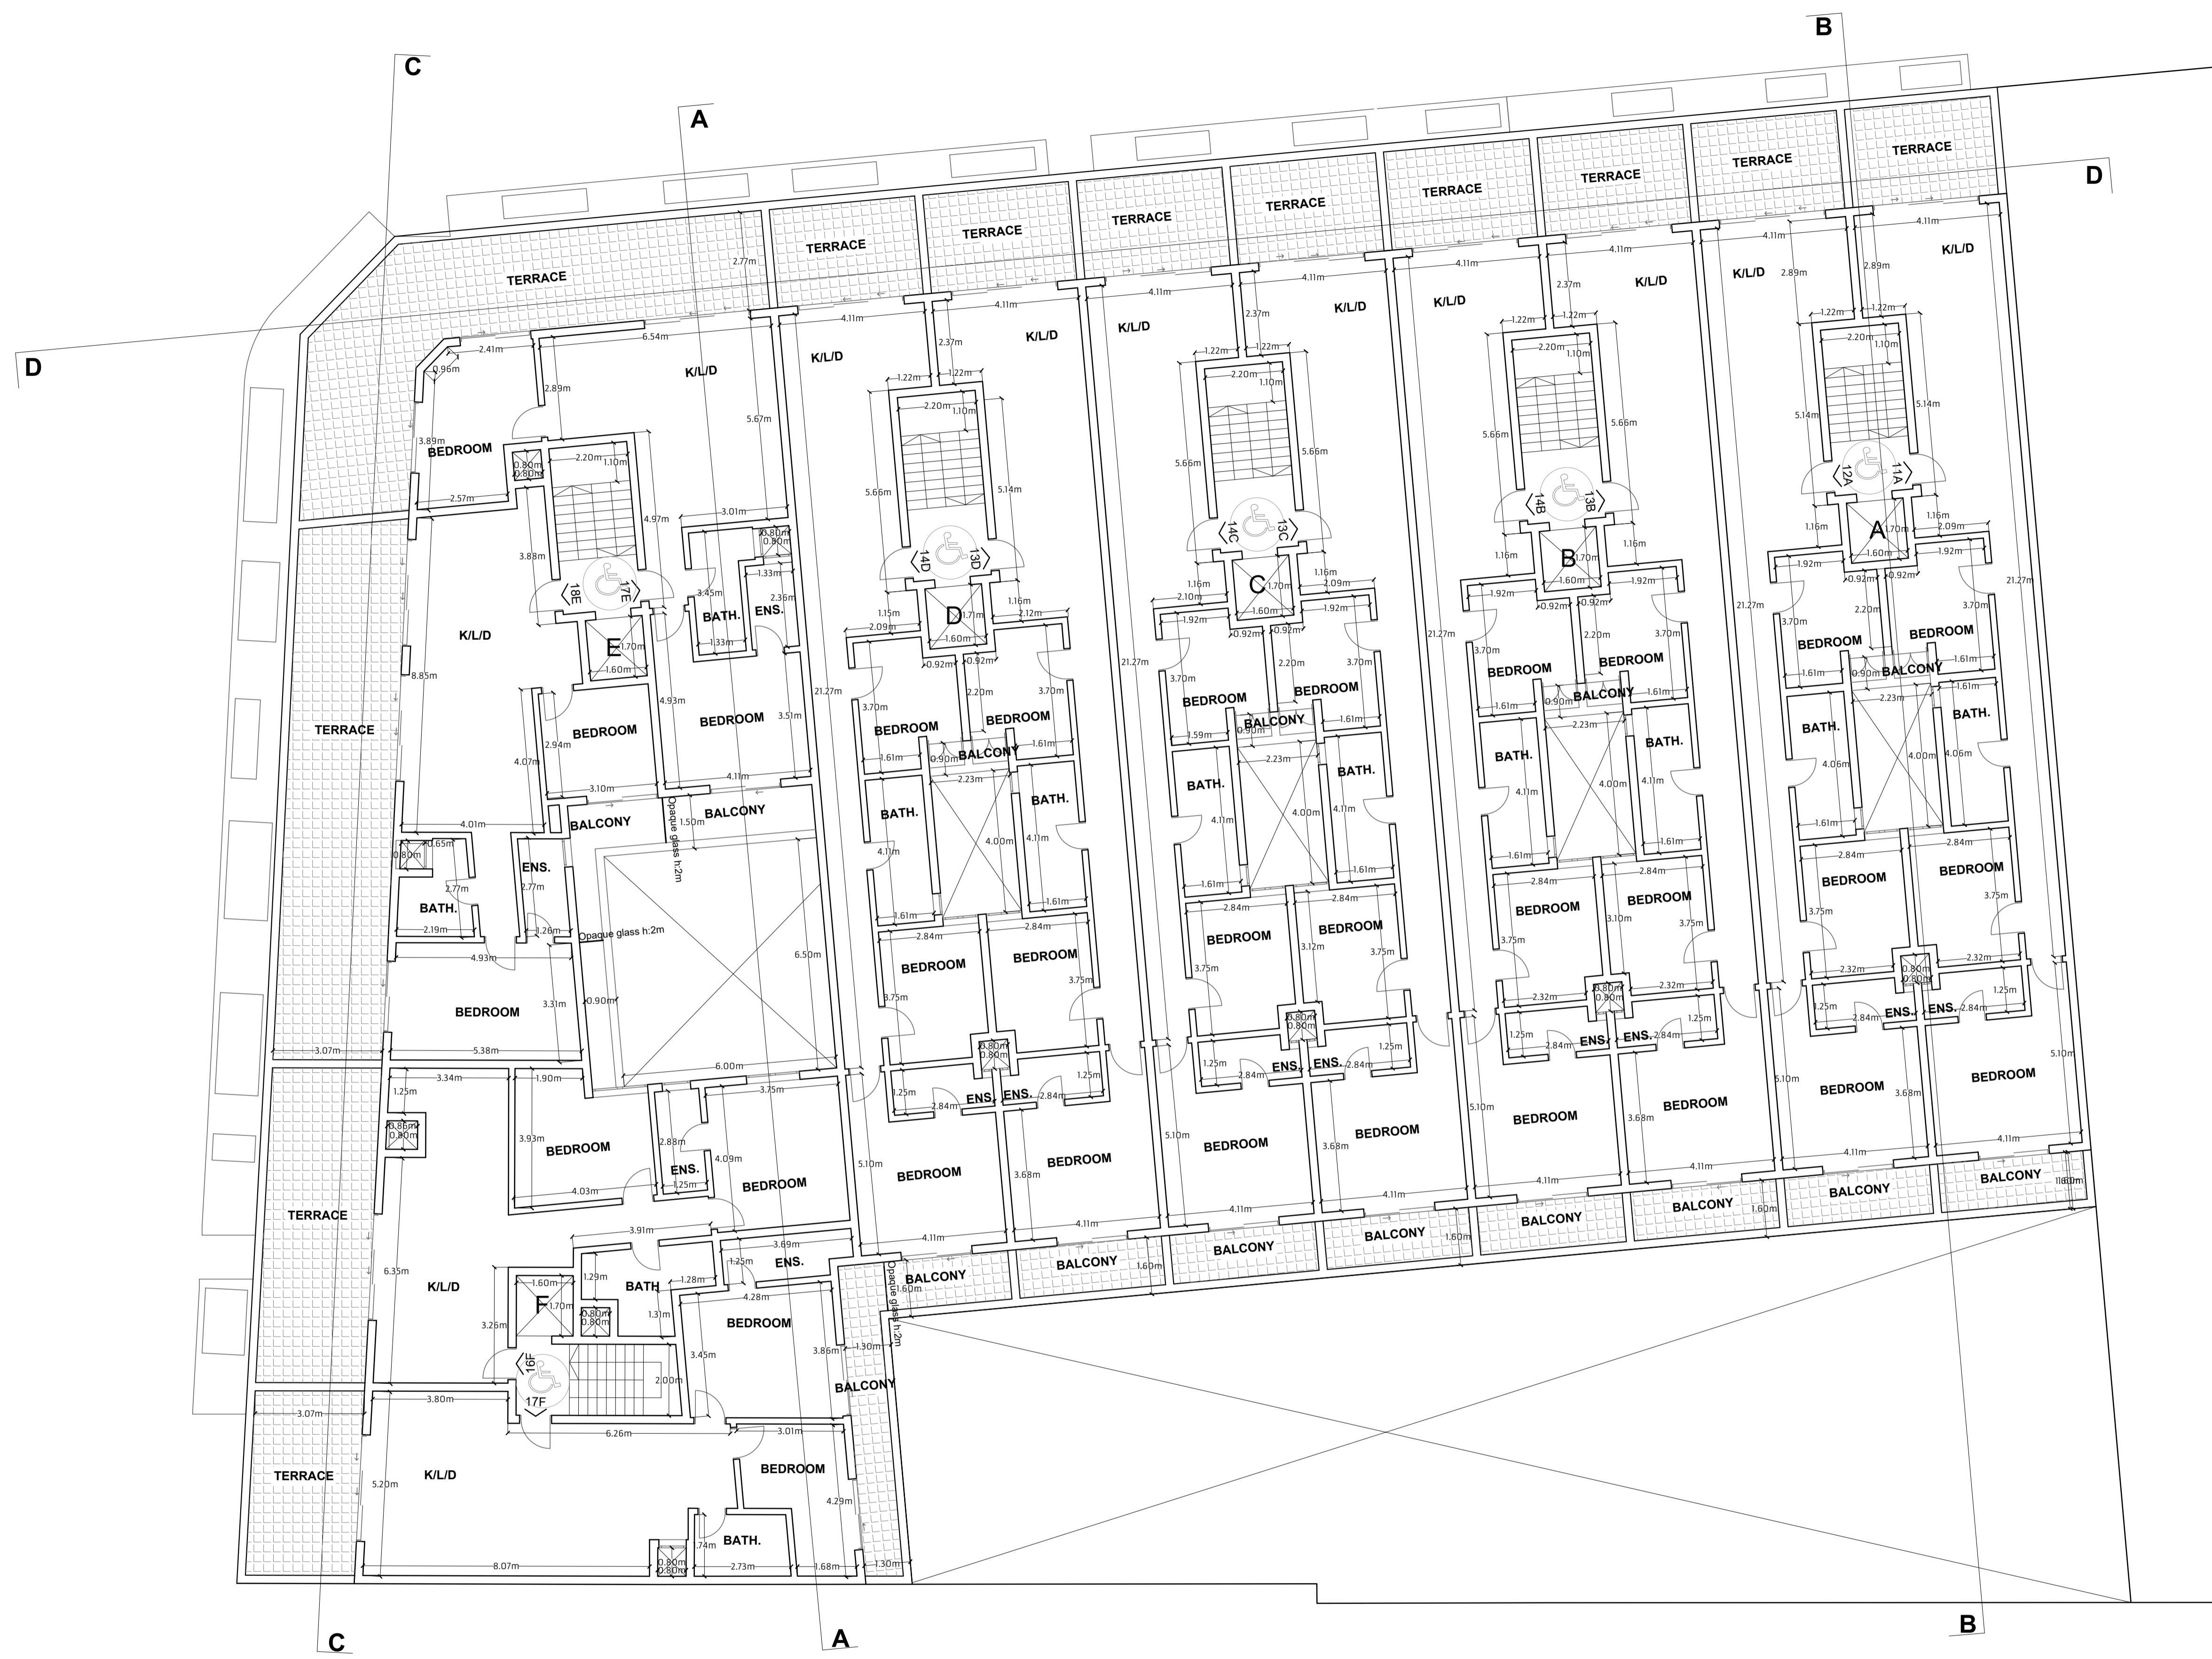


Approved 6th Floor (Penthouse)  
Scale 1:100

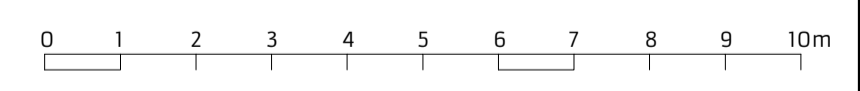






As built -1  
Scale 1:100

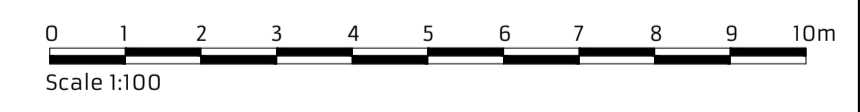

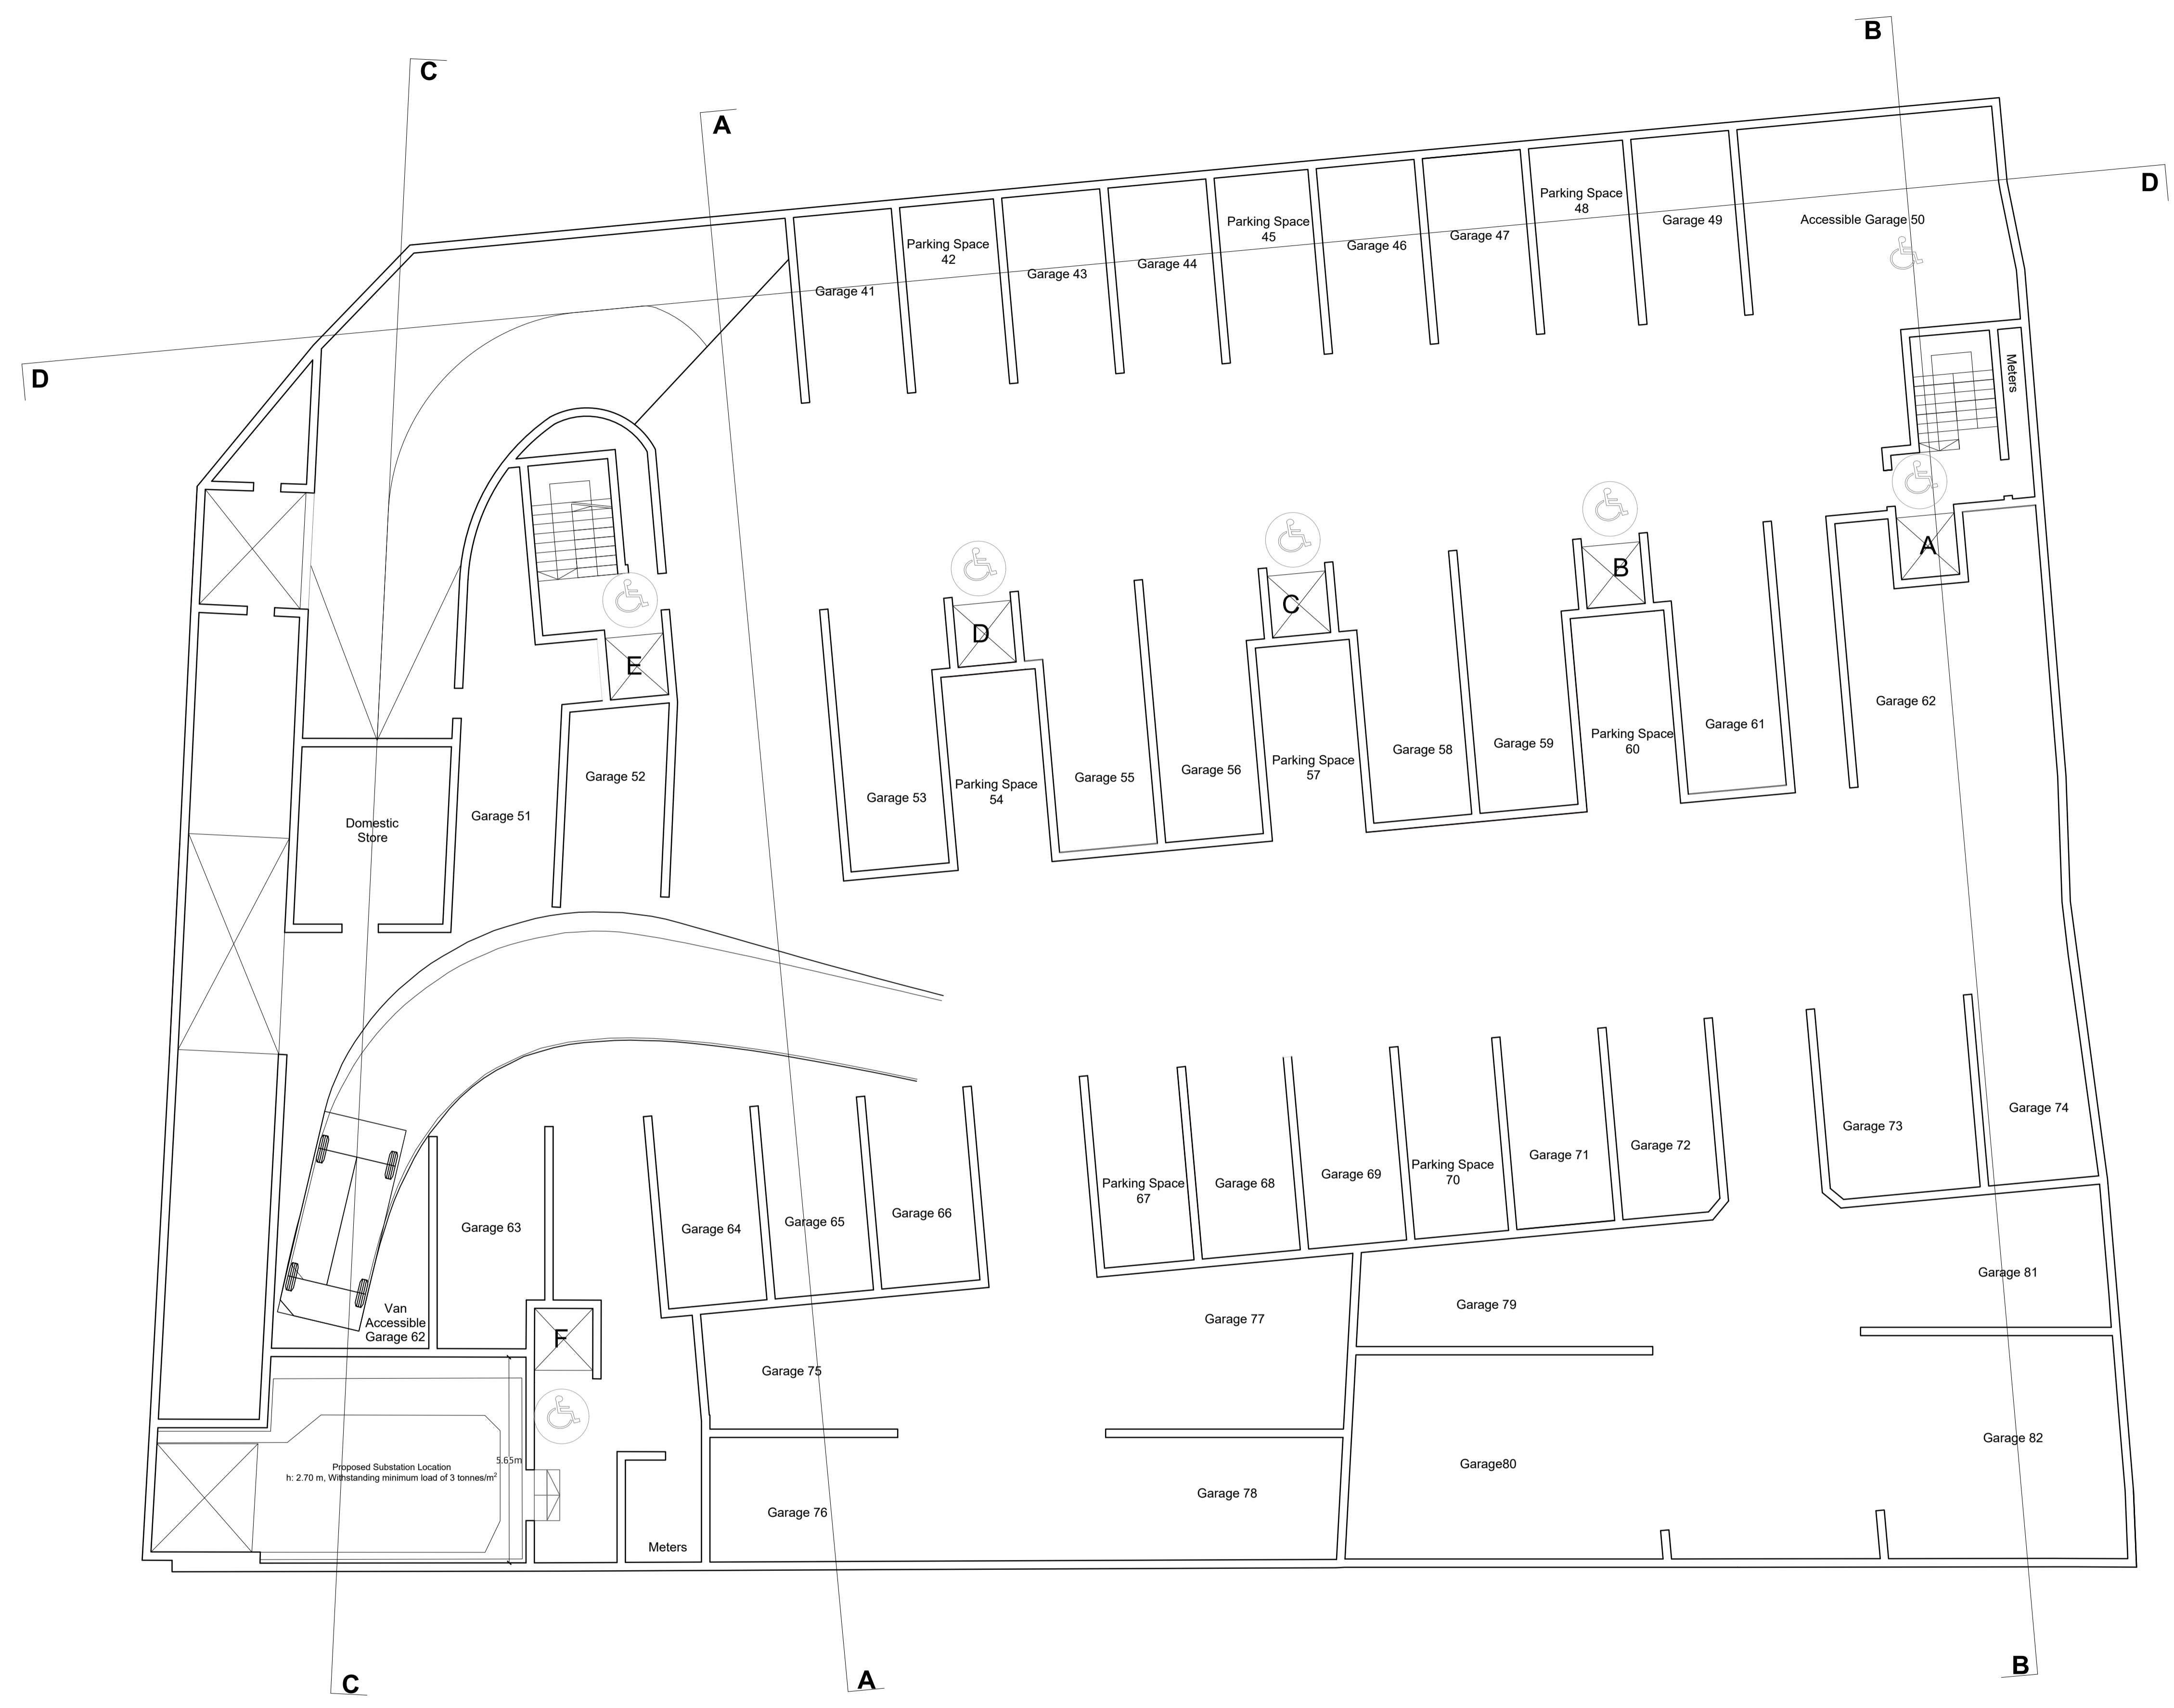

As built level -2  
 Scale 1:100

