




Approved - Semi Basement Floor Plan
Scale 1:100 PA 3656 / 07

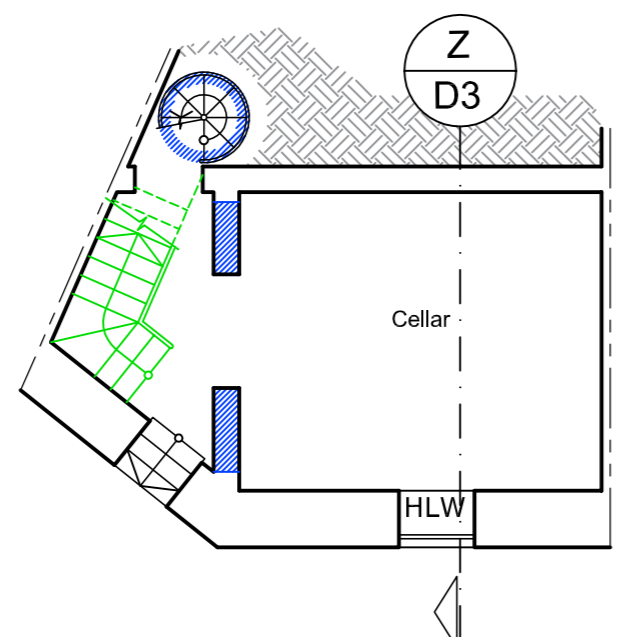


To Sanction - Semi Basement Floor Plan
Scale 1:100

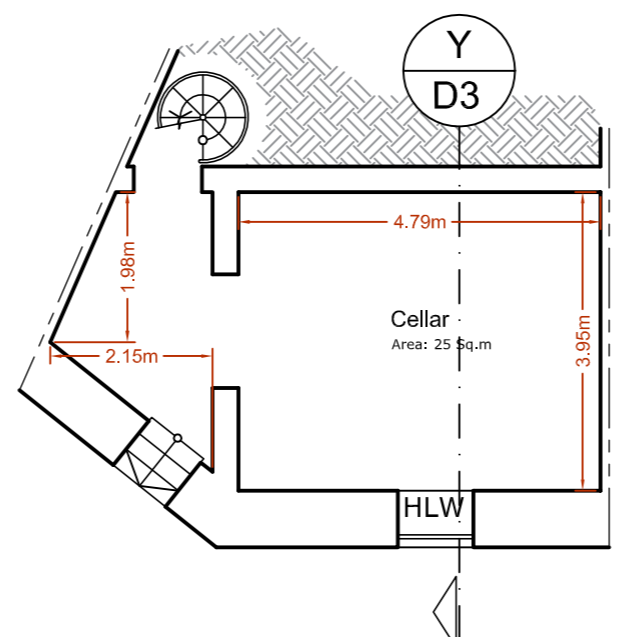


As Built - Semi Basement Floor Plan
Scale 1:100

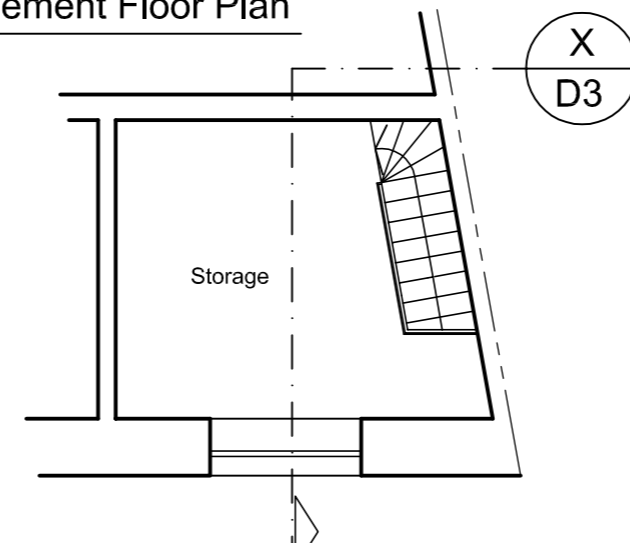


Approved - Intermediate Floor Plan
Scale 1:100 PA 3656 / 07

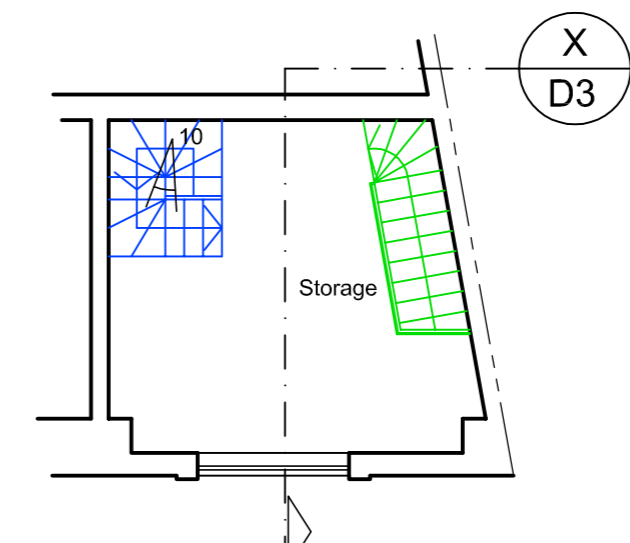


To Sanction - Intermediate Floor Plan
Scale 1:100 Correct measurements following survey

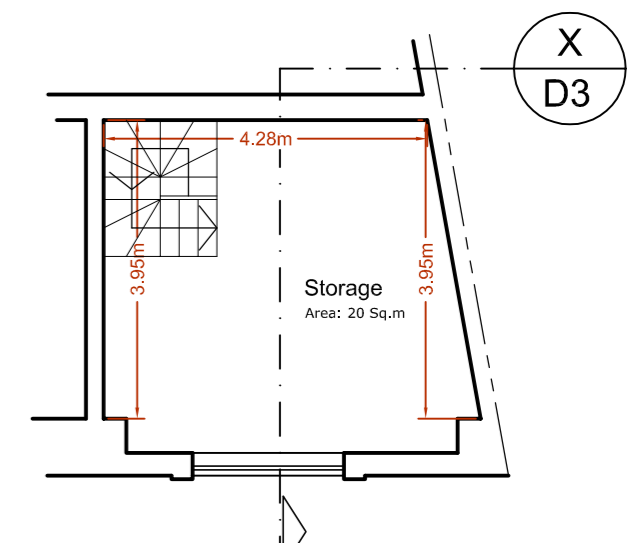


As Built - Intermediate Floor Plan
Scale 1:100

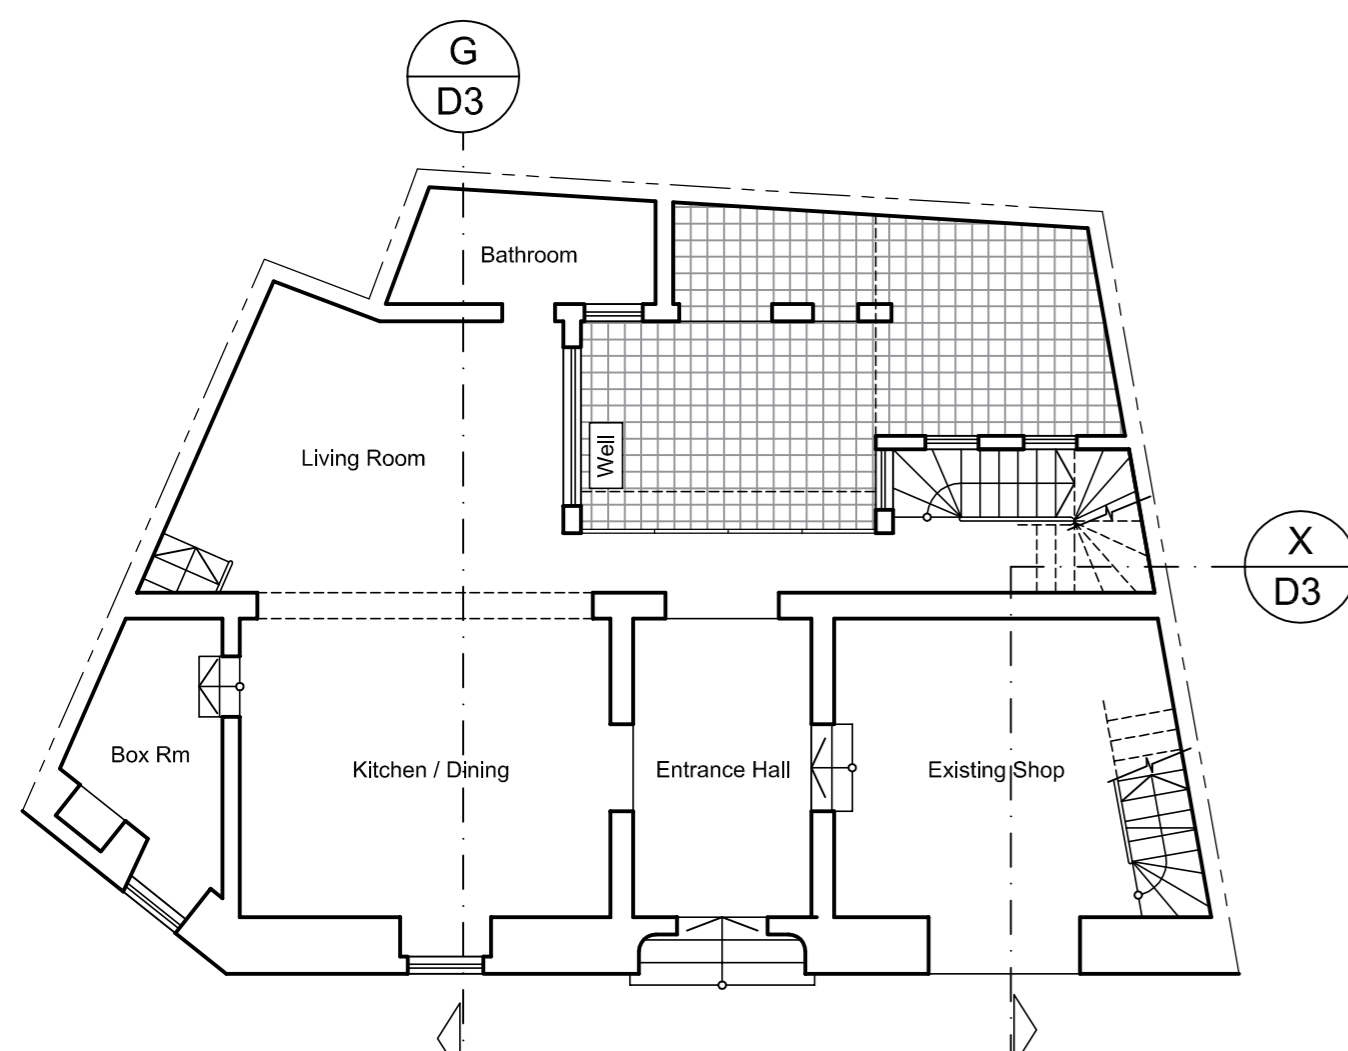


Approved - Ground Floor Plan
Scale 1:100 PA 3656 / 07

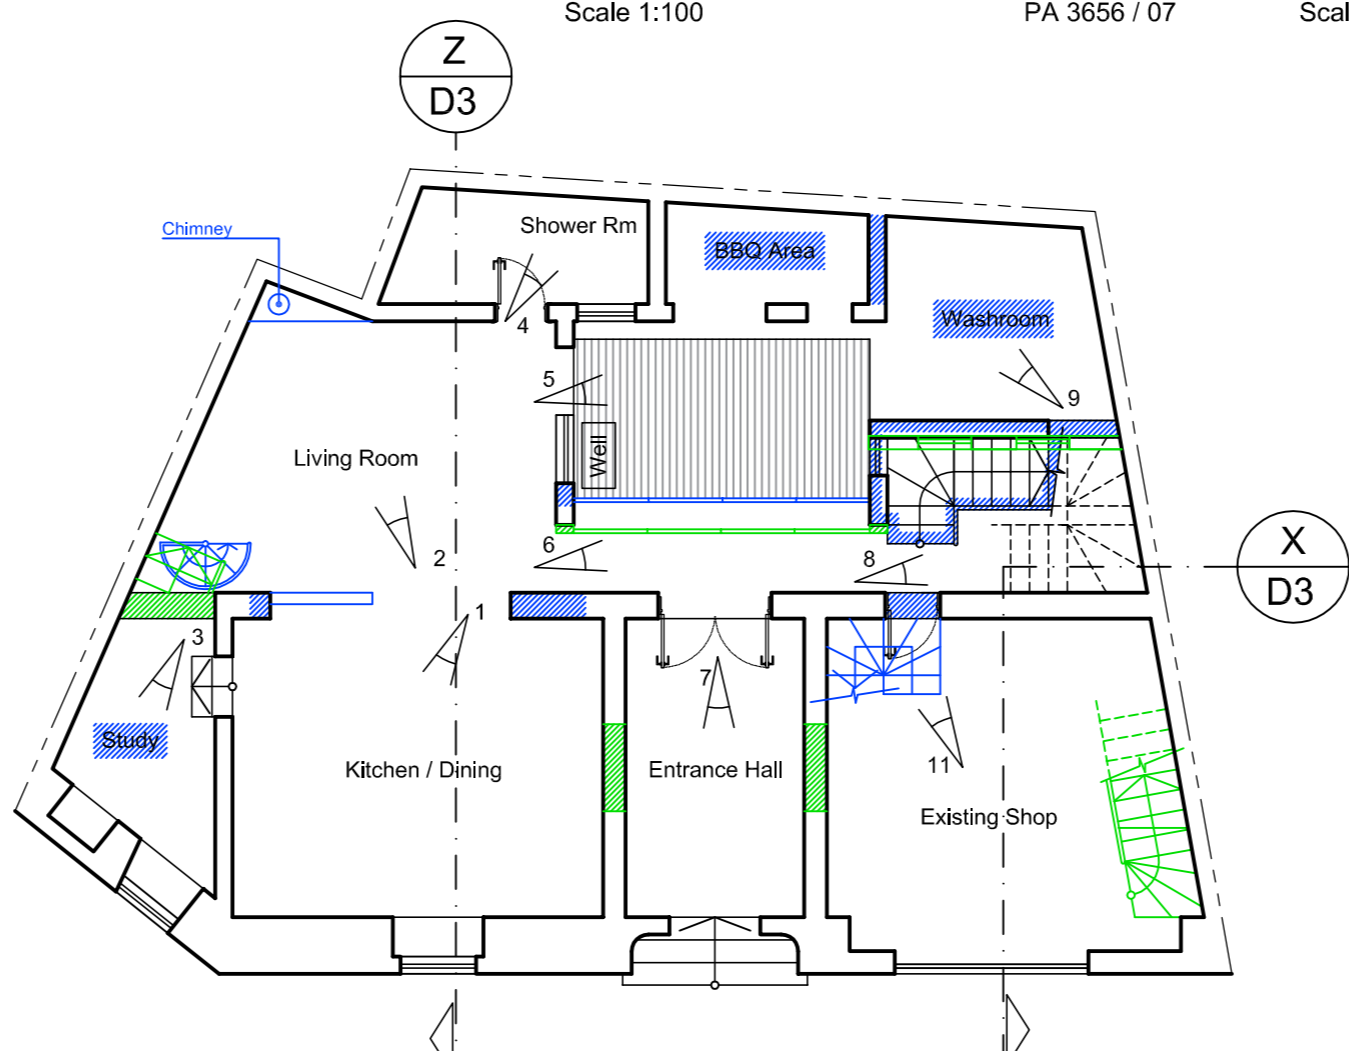


To Sanction - Ground Floor Plan
Scale 1:100 Correct measurements following survey

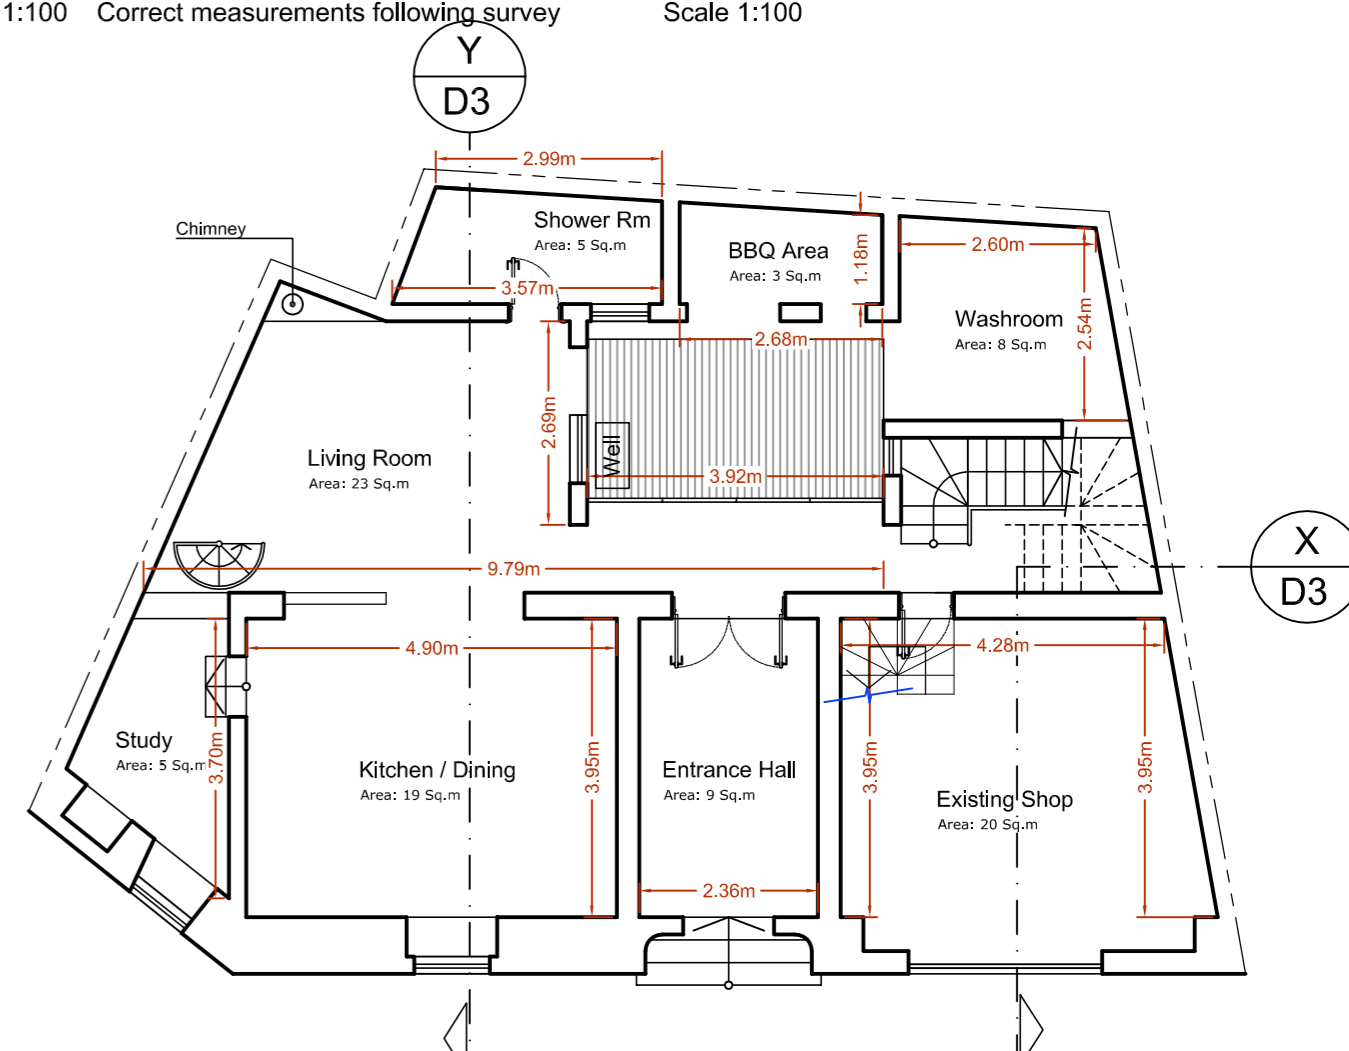


As Built - Ground Floor Plan
Scale 1:100

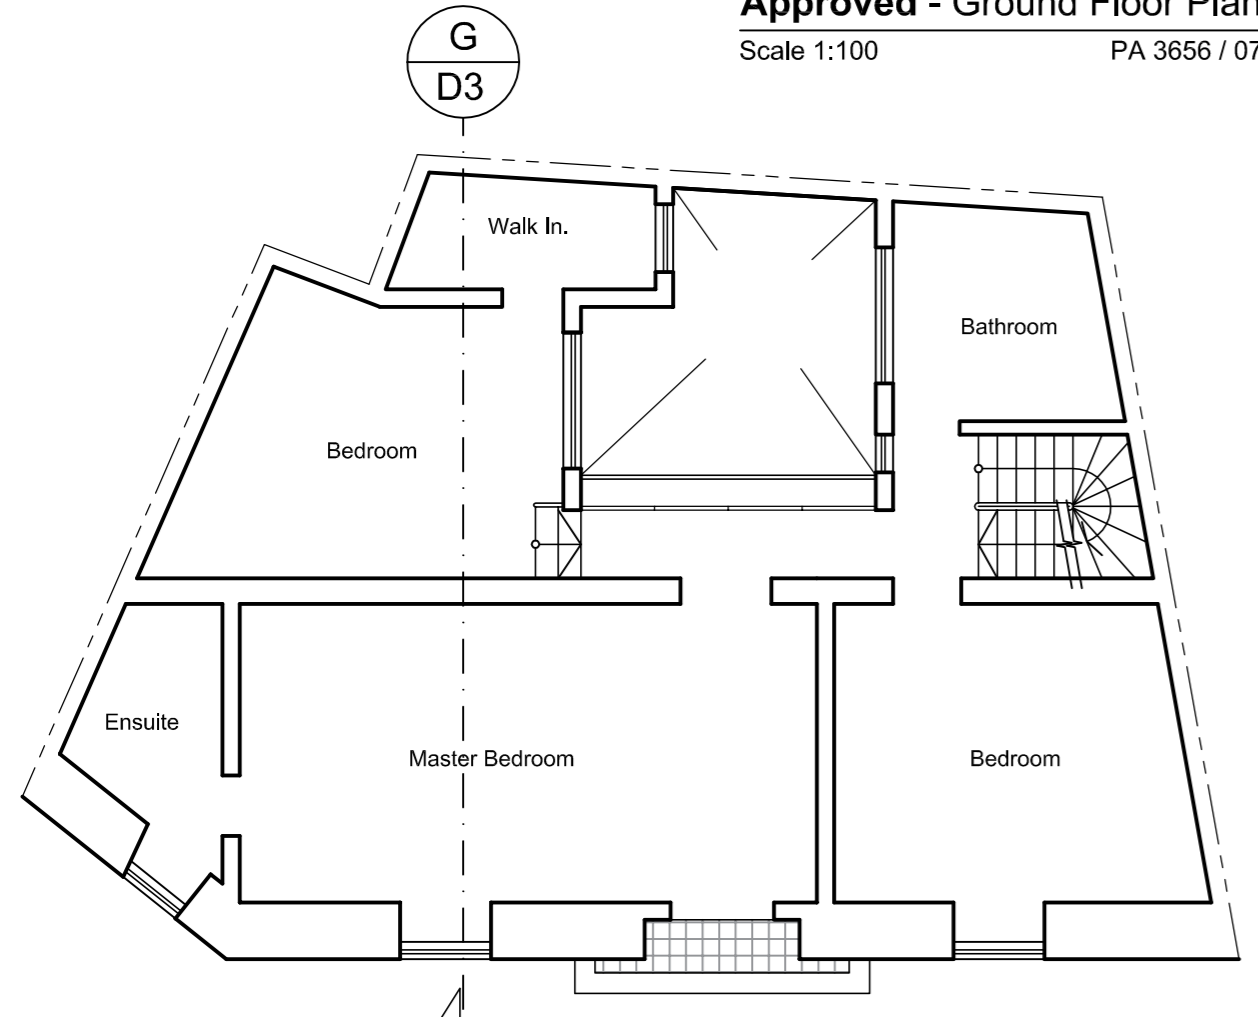


Approved - First Floor Plan
Scale 1:100 PA 3656 / 07

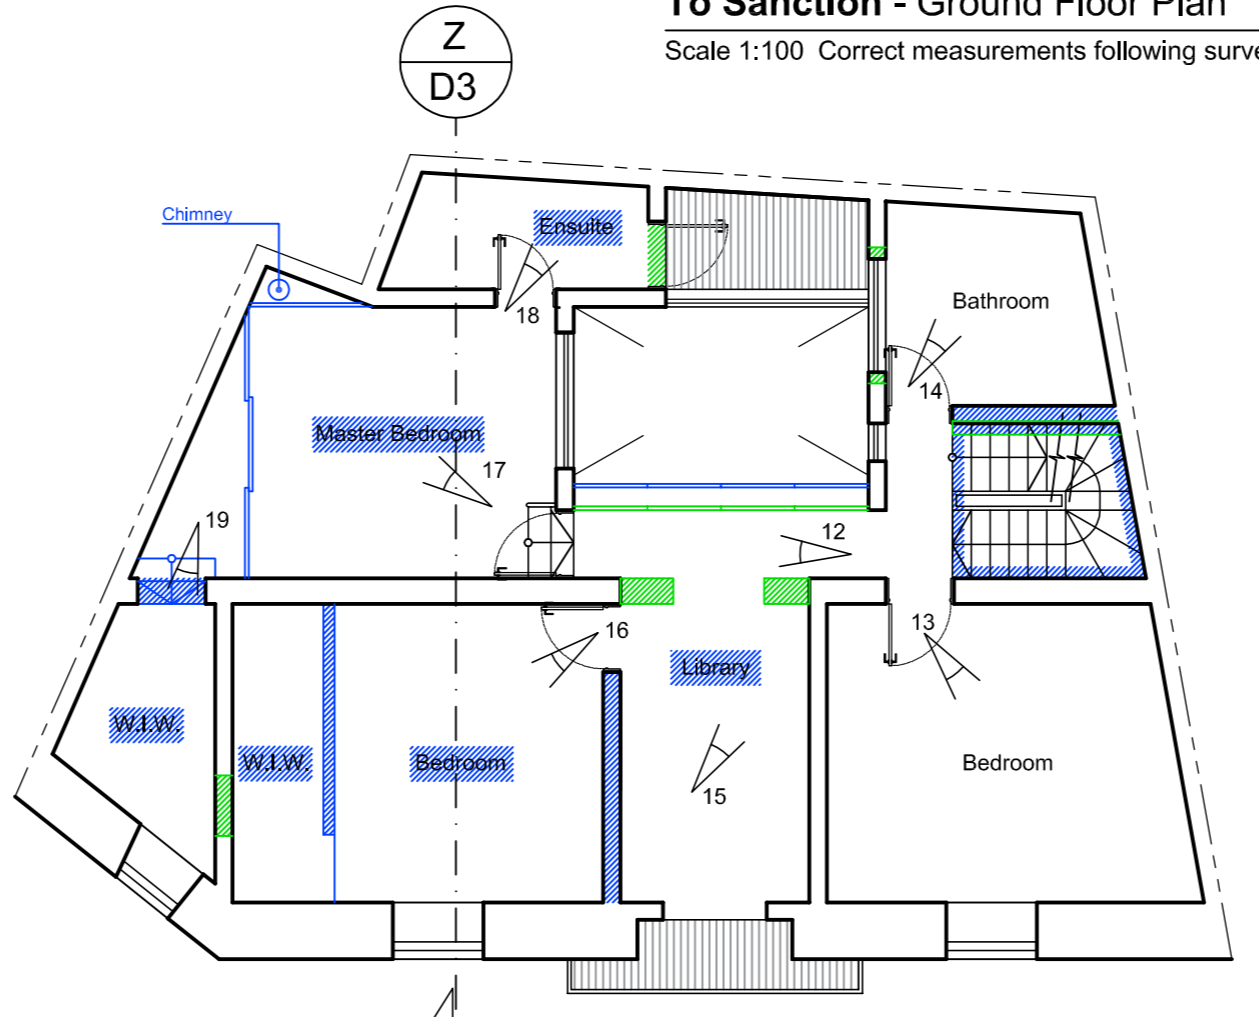


To Sanction - First Floor Plan
Scale 1:100 Correct measurements following survey

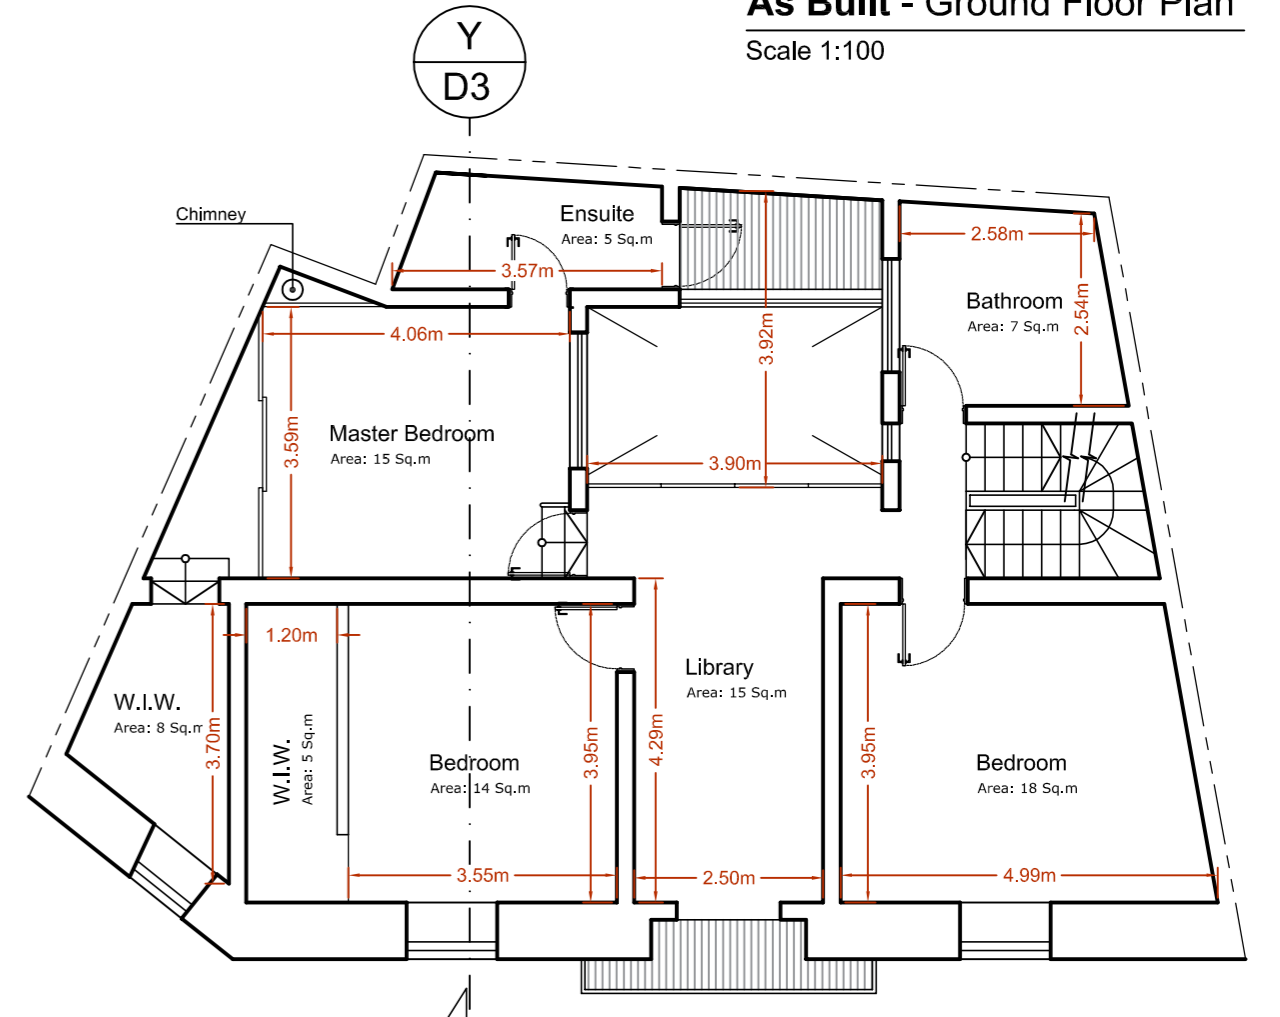


As Built - First Floor Plan
Scale 1:100

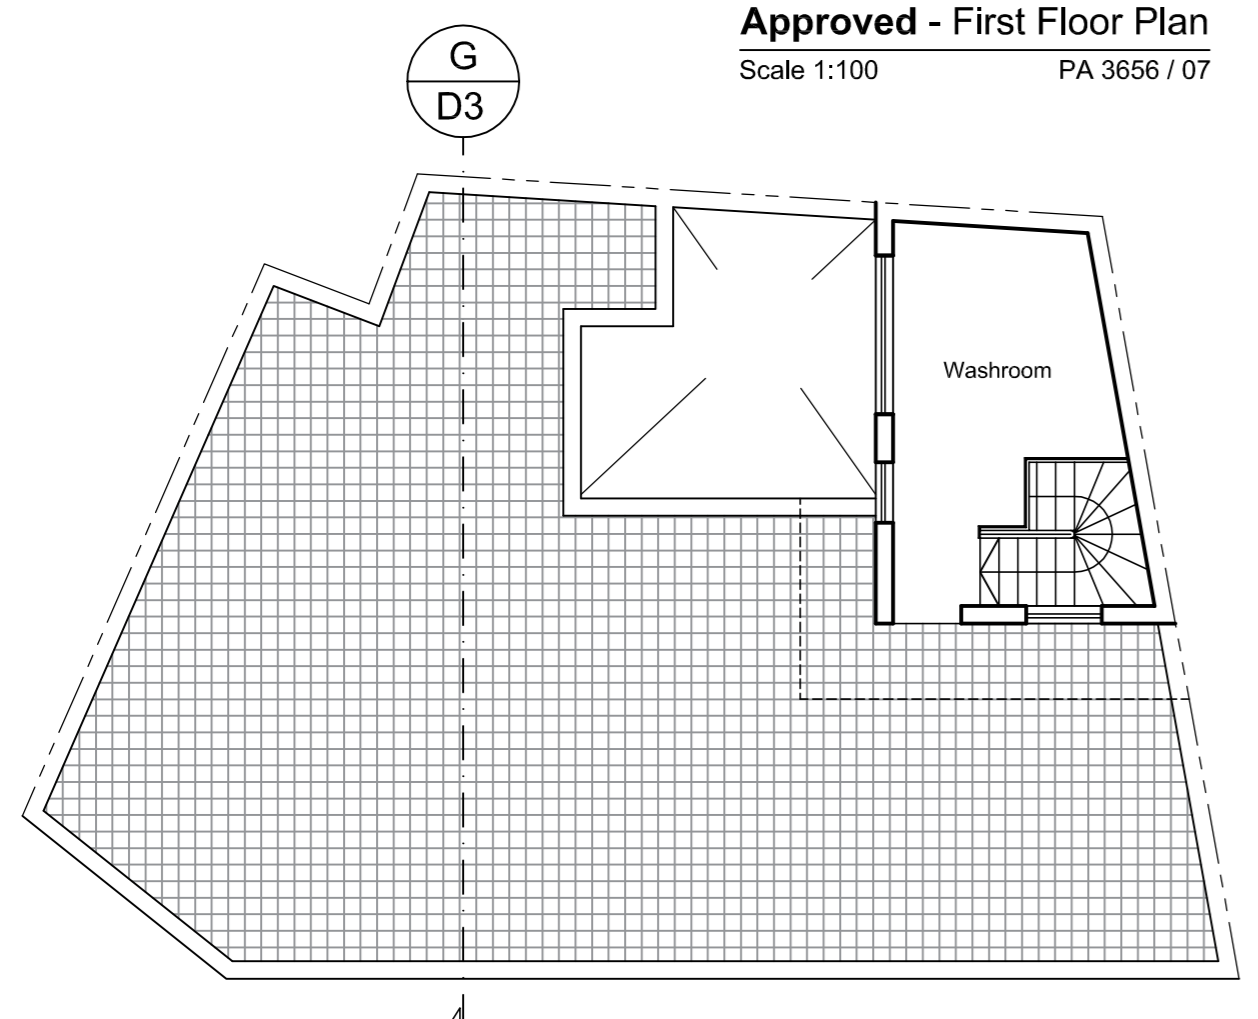


Approved - Roof Plan
Scale 1:100 PA 3656 / 07

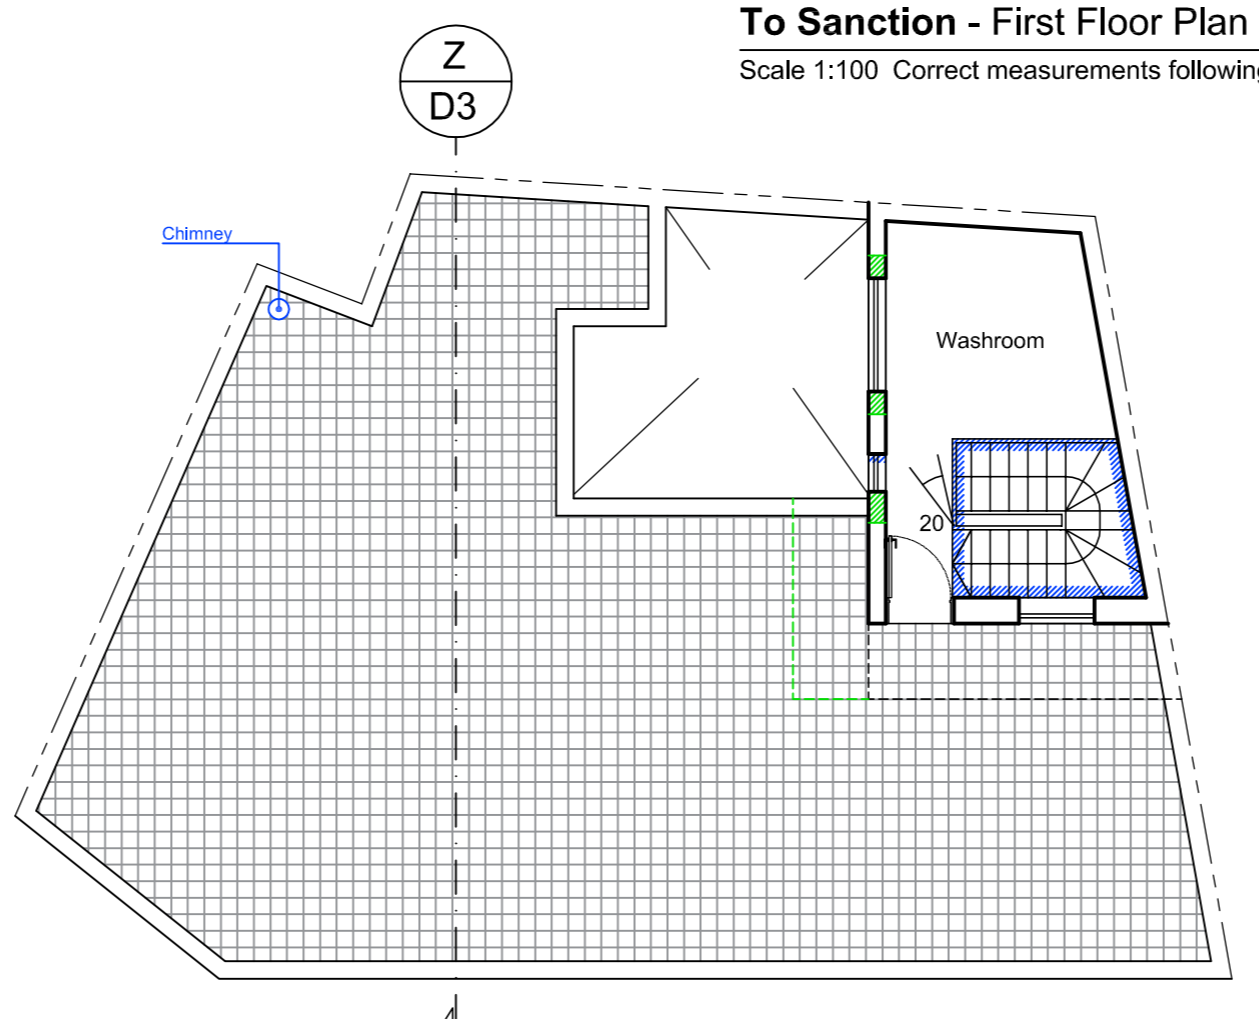


To Sanction - Roof Plan
Scale 1:100 Correct measurements following survey

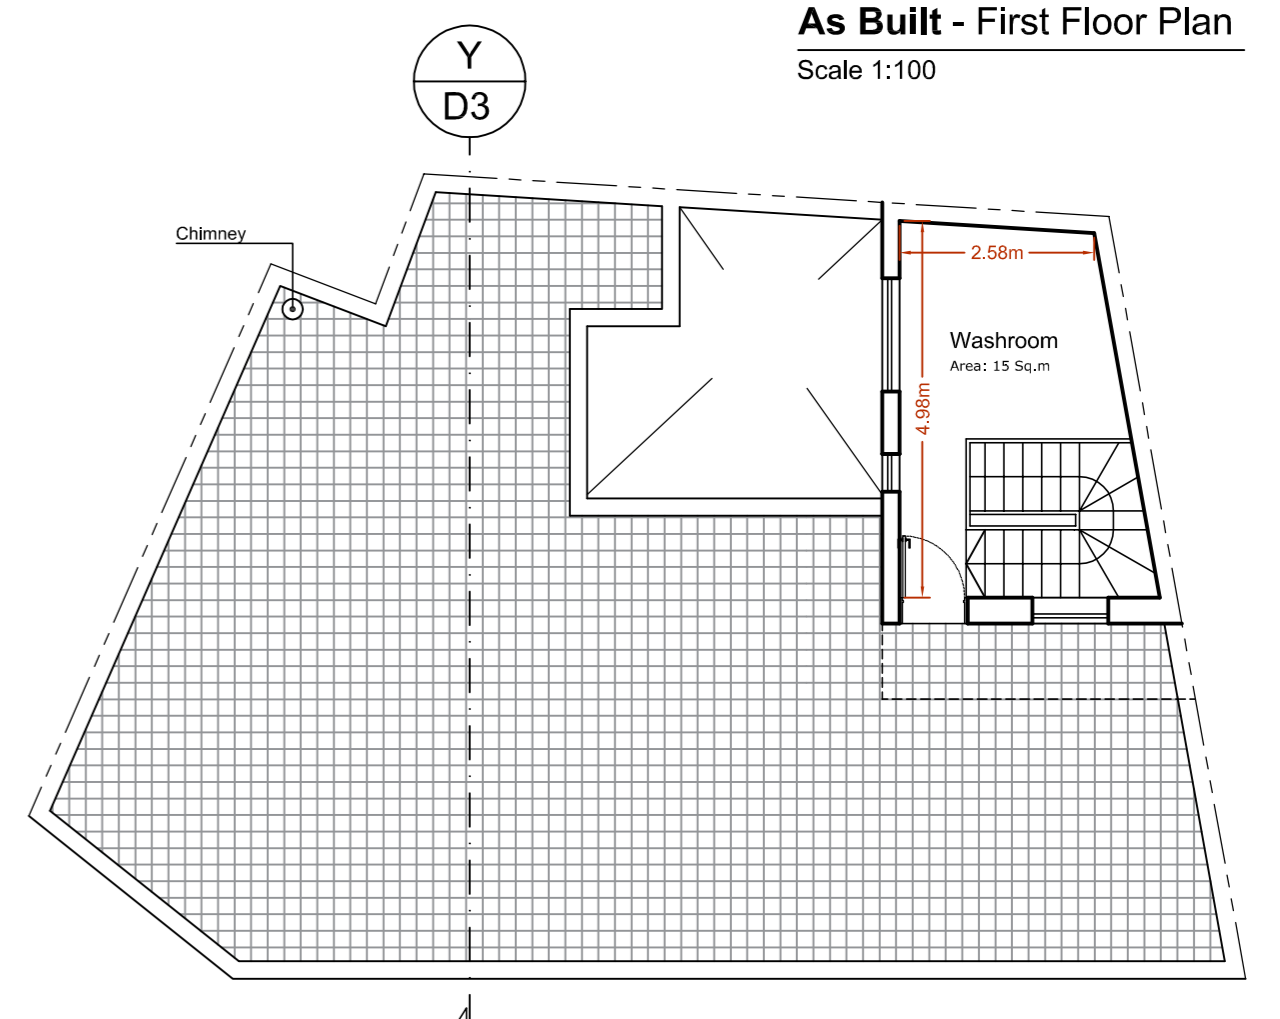


As Built - Roof Plan
Scale 1:100

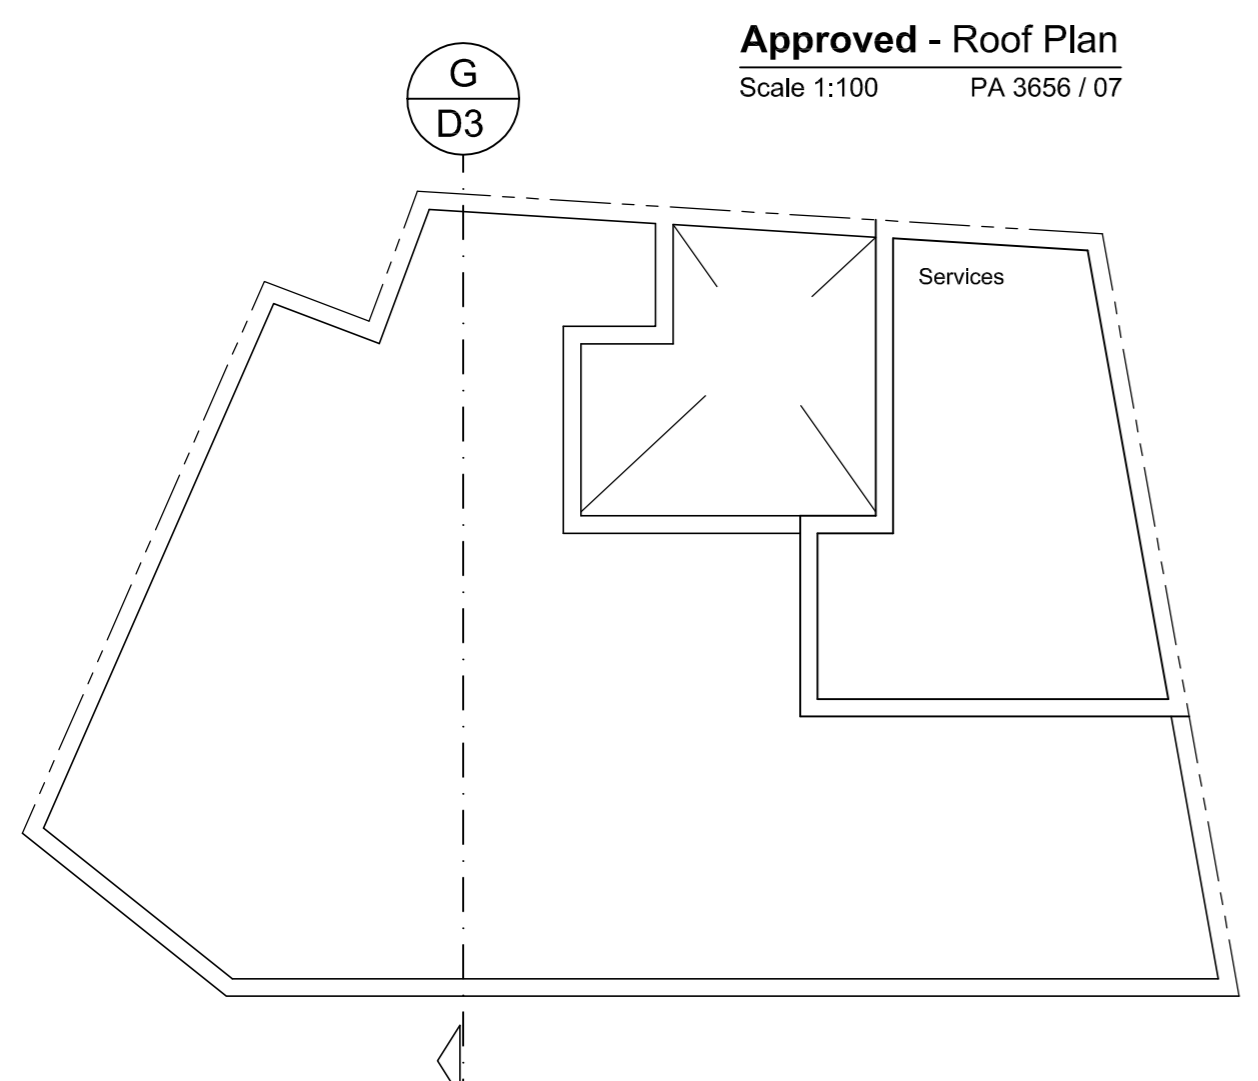



Approved - Over Roof Plan
Scale 1:100 PA 3656 / 07

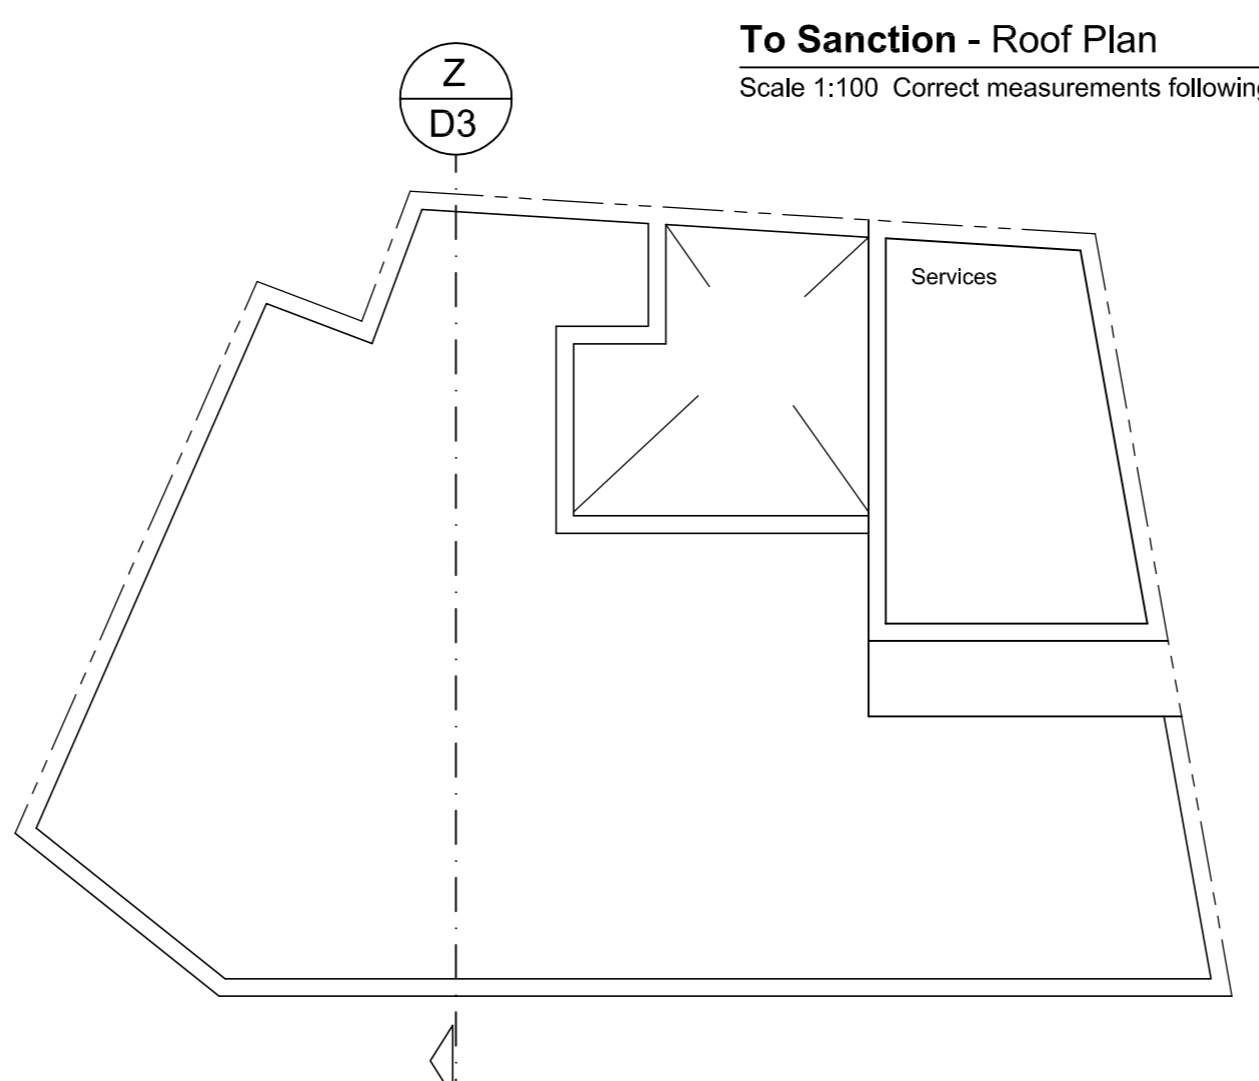

To Sanction - Over Roof Plan
Scale 1:100 Correct measurements following survey

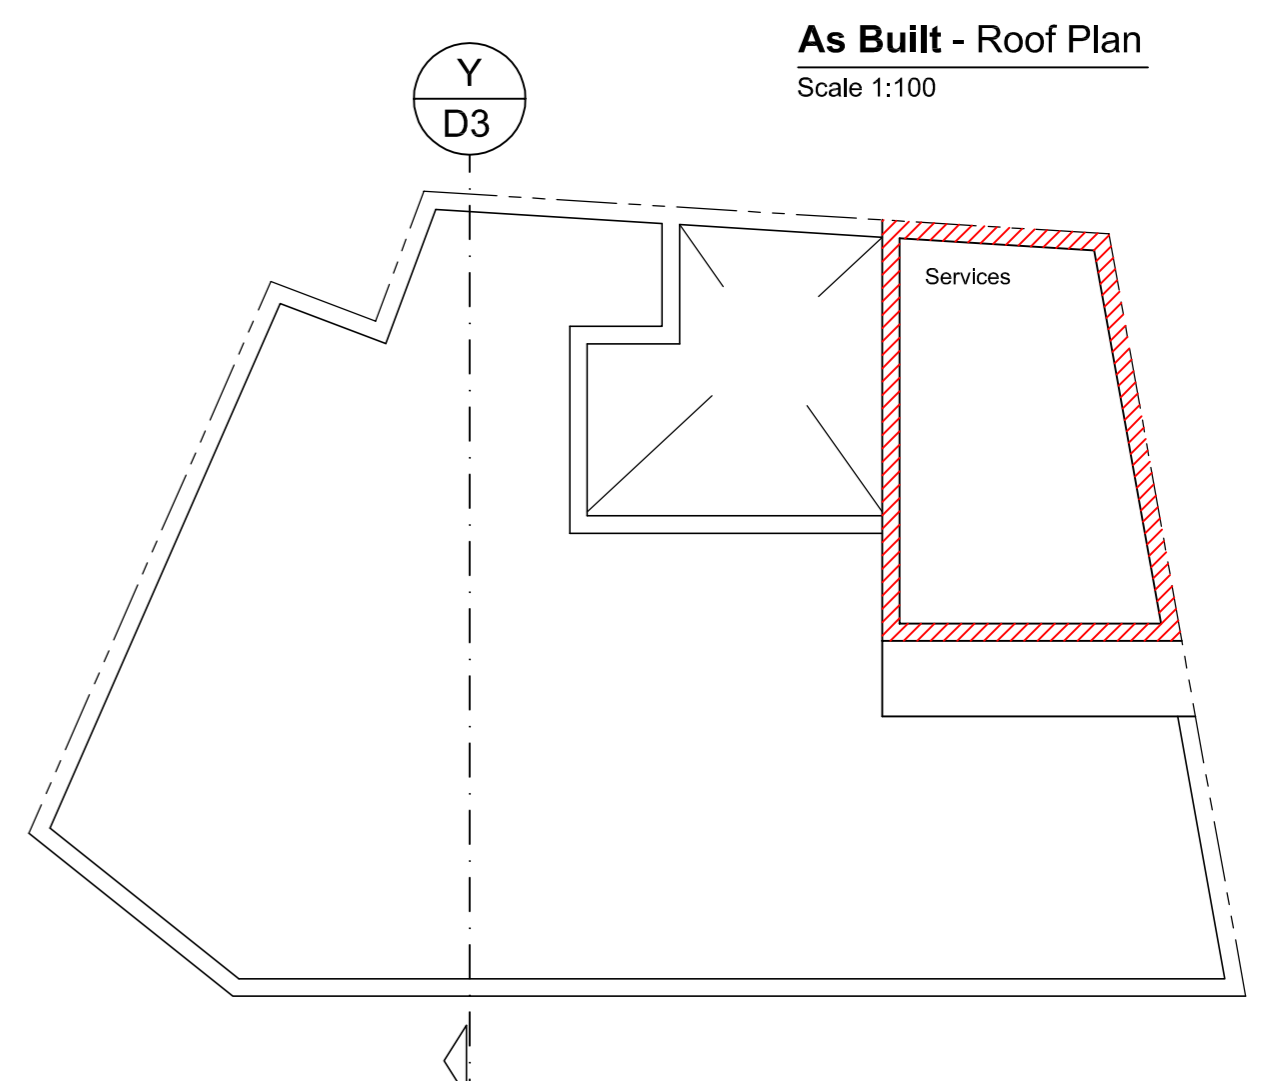

As Built/Proposed - Over Roof Plan
Scale 1:100

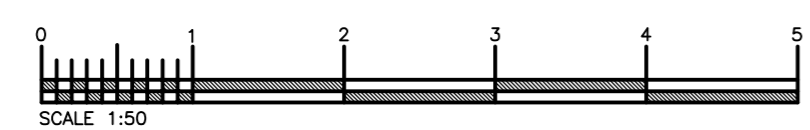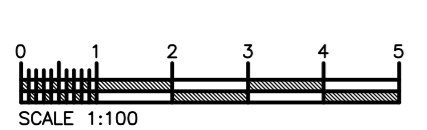

Project: TO SANCTION EXISTING TERRACED HOUSE AS BUILT
Drawing Title: APPROVED, TO SANCTION AND AS BUILT FLOOR PLANS

Client: Jonathan Schembri
Date: 05 / 01 / 19
Scales: AS SHOWN
Job No.: 19004
Drng No.: 01