



Approved Level 1 (PA/00017/21)  
Scale 1:100

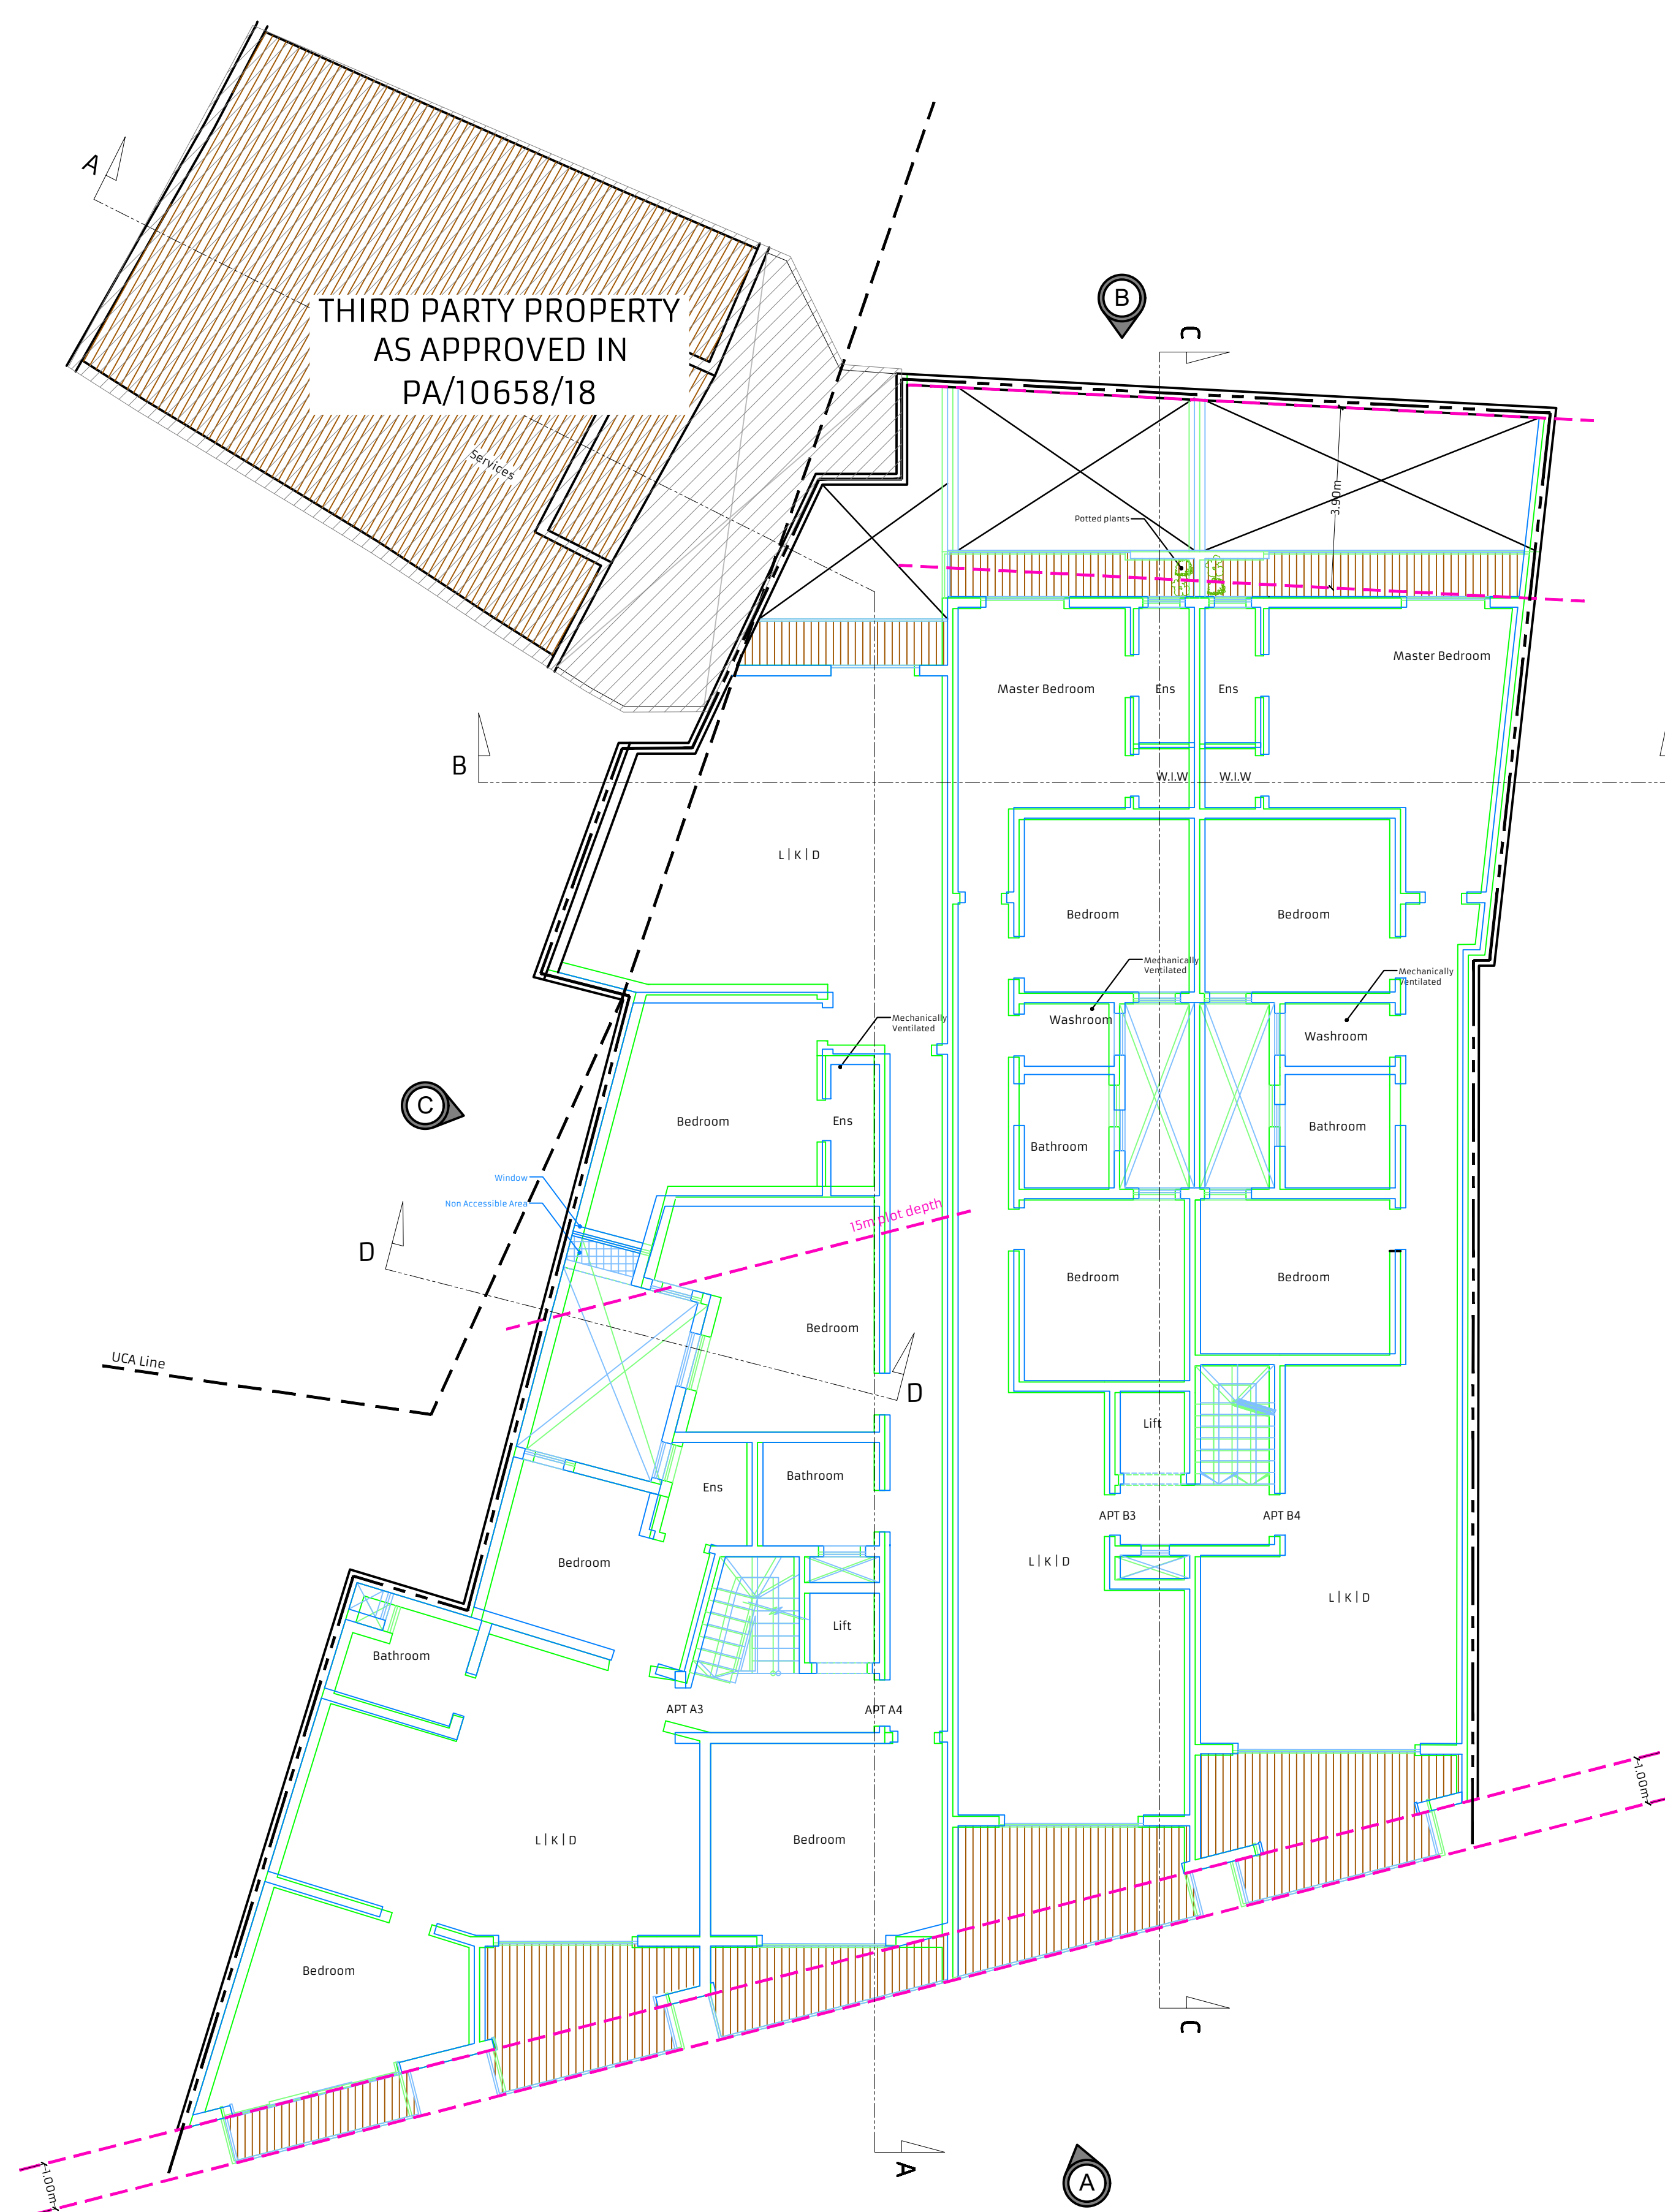

Proposed Level 1, to Sanction  
Scale 1:100

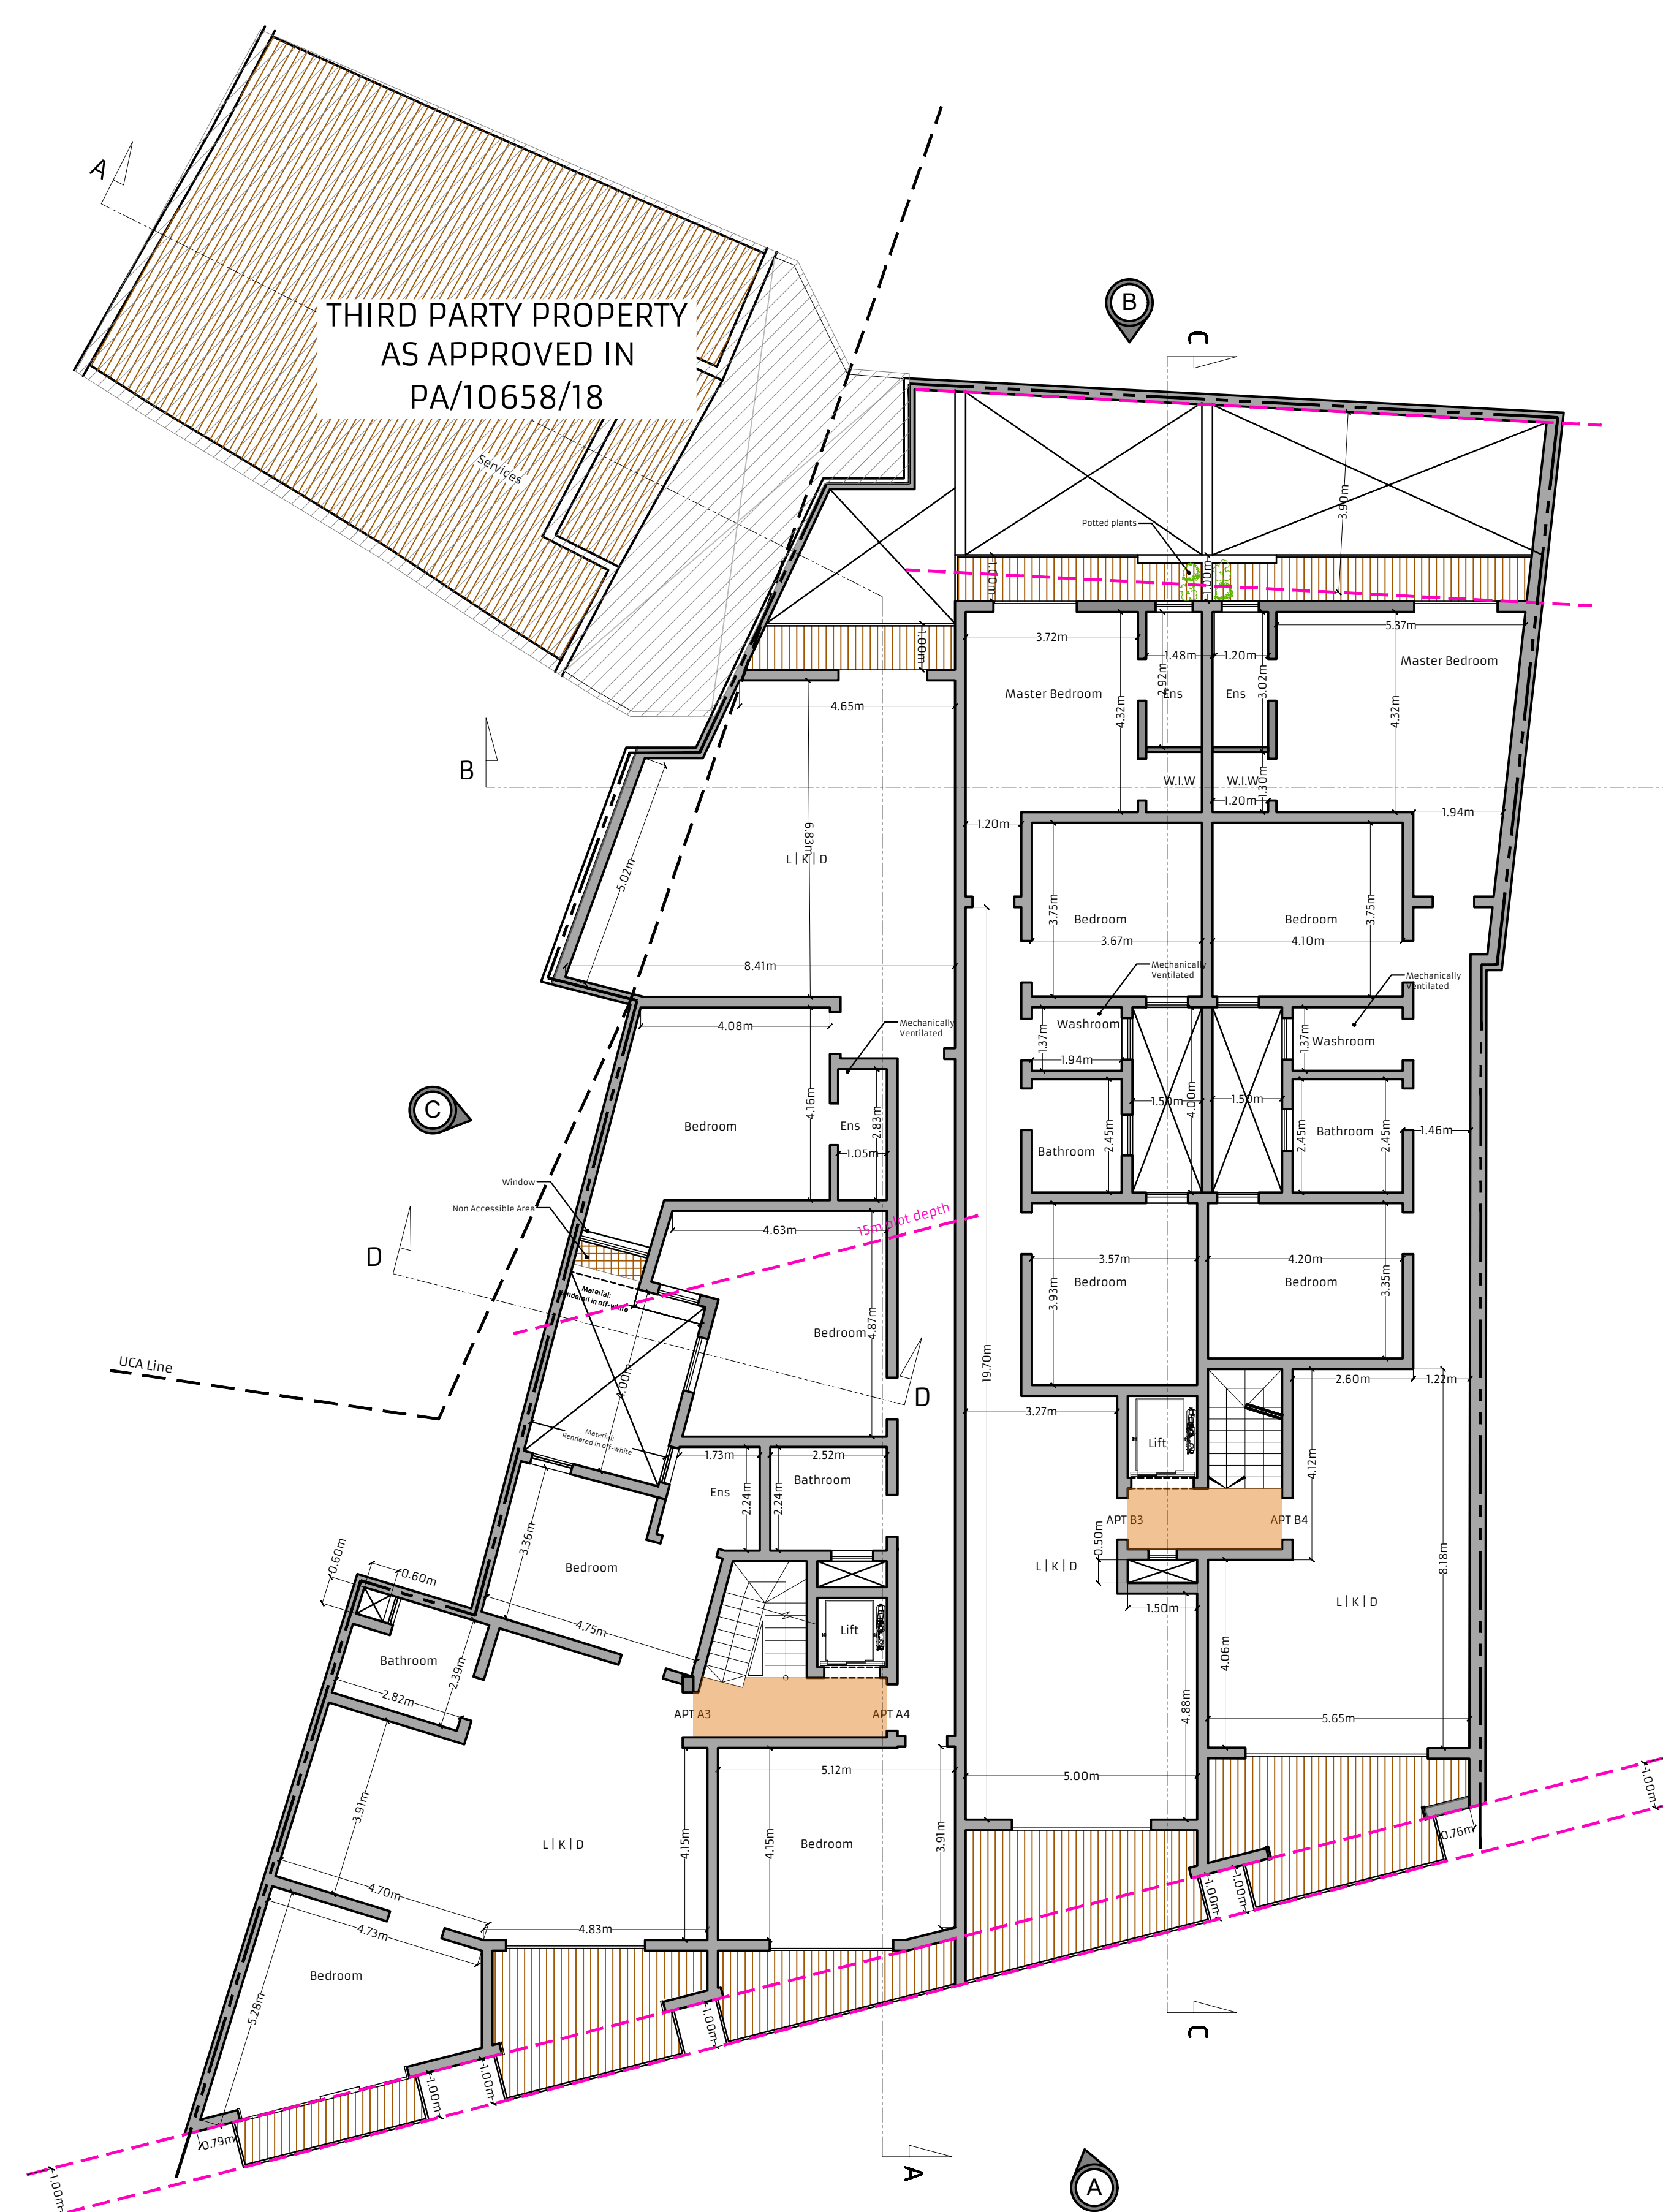

Proposed Level 1 (Clean)  
Scale 1:100



(1) This drawing is the sole property of the architect. It should not be copied or transmitted by any means, in whole or in part, without the permission of the architect.

(2) All dimensions are in millimeters unless stated otherwise and should not be scaled directly from the drawing. All dimensions are to be checked by the Contractor and are to be his responsibility.

(3) Any missing or conflicting information is to be reported to the Architect (Perit) in charge immediately upon discovery.

Project Title: Minor Changes in Elevation, Levels and Plans from approved PA/00017/20	
Drawing Title: Level 1 Plan	
Drawing Number: A003	Project Number: 2050

Client: Mr. E Farrugia / Mr. T Farrugia	
Architect: D. Grima	Paper Size: A0
Drawn By: S.B/M.C	Scale: 1:100
Checked By: D. Grima	Revision:
Date: 22-06-2022	012345

Notes:	
	Proposed Construction
	Proposed Demolition
	As Constructed To Sanction
	Approved but not Constructed

Structural // Architectural // Solutions  
5/2, Collegiate Street, Birkirkara, Malta BKR 1361  
m: (+356) 99878005  
t: (+356) 27021706  
e: info@sasmalta.com  
w: http://www.sasmalta.com

Copyright© SAS Malta, 22nd June 2022