


APPROVED ELEVATION
SCALE 1:100

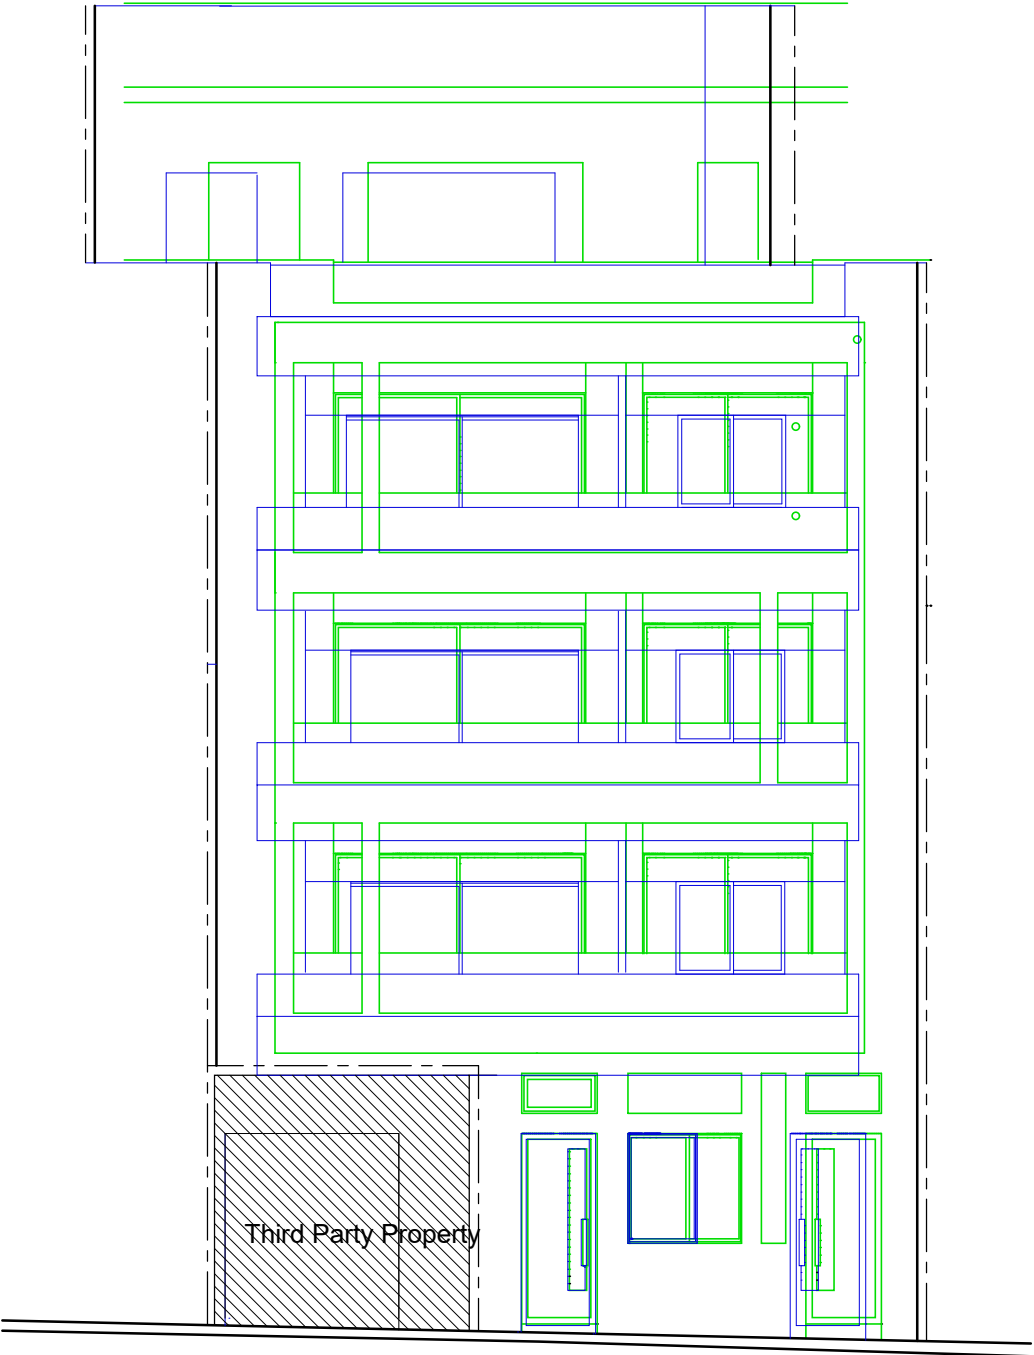

SUPERIMPOSED ELEVATION
SCALE 1:100

Notes

This drawing is the copy right of the author and cannot be copied, reproduced, retained or disclosed to any unauthorised person.

This drawing should not be scaled.

Legend

- To Construct
- To Demolish
- As Constructed; To Sanction
- Approved but not constructed; To Sanction

Drawing
Approved/Existing
Elevation

Scale 1:100 @ A3 Job No 19010 Dwg No 09 Date 10.08.2021

Architect
Henry Attard

Drawn By: K.E Checked By: M.M

Project
Minor Amendment

Client
Muscat Sharlo

Site
Mosta

2, Triq iz-Znuber,
Attard, ATD 2800
Malta
T (+356) 21422617
M (+356) 99423098
E info@tps.com.mt
W www.tps.com.mt

