



APPROVED RECEDED FLOOR PLAN
CLEAN COPY SCALE 1:100

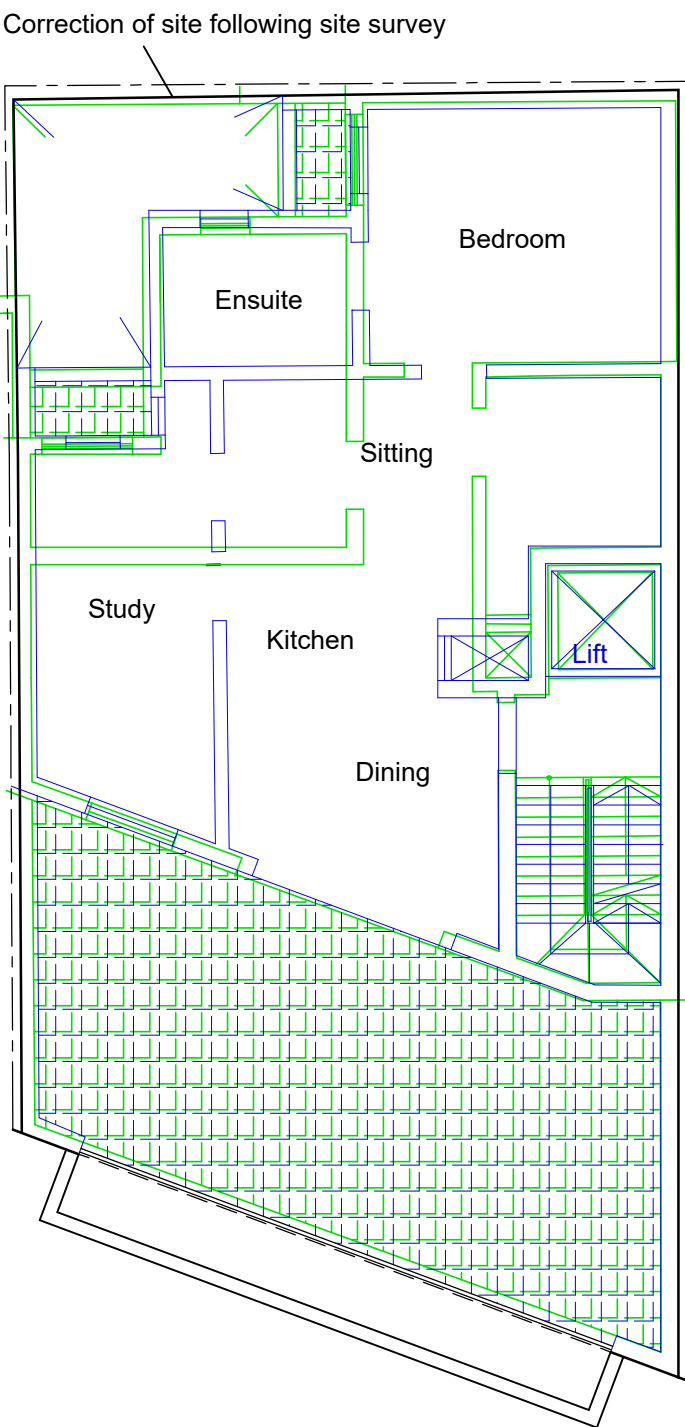

SUPERIMPOSED RECEDED FLOOR PLAN
SCALE 1:100

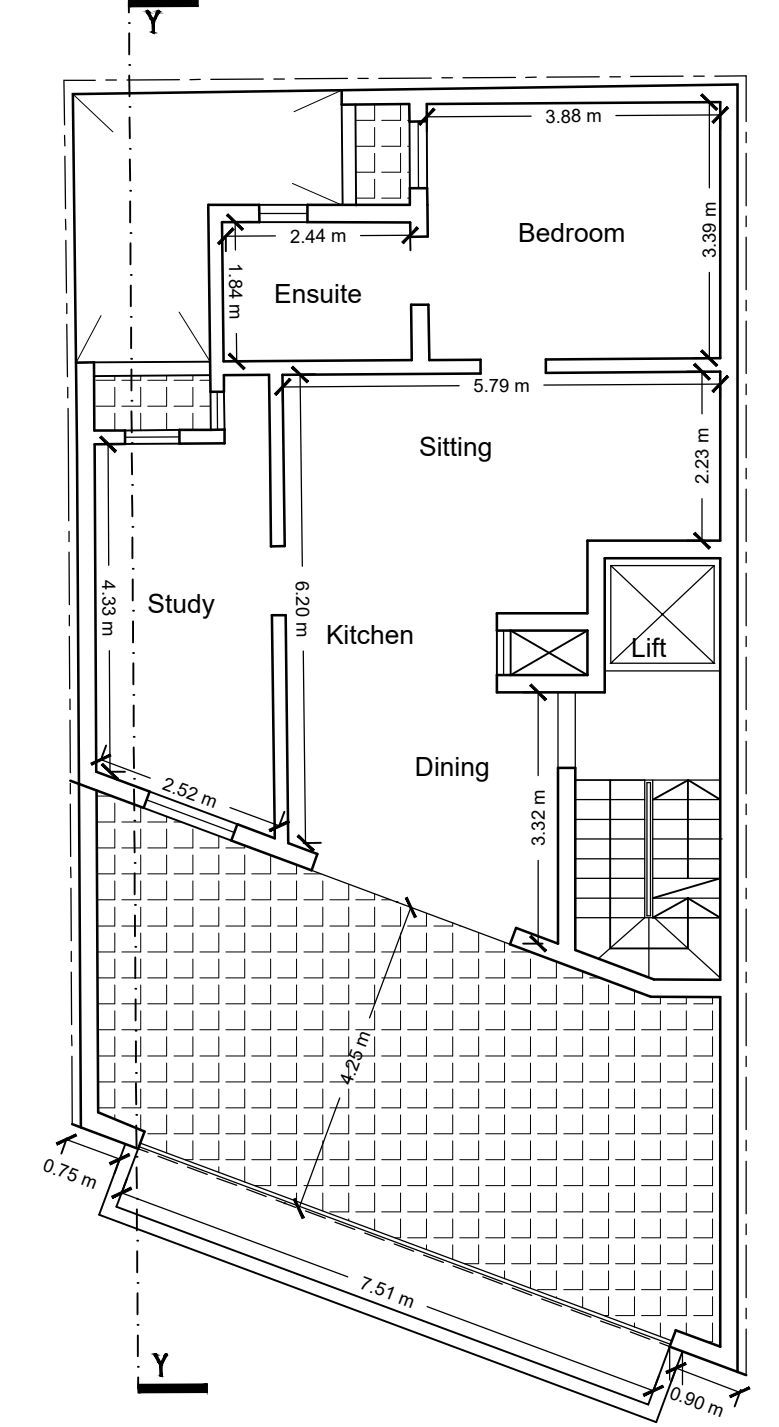

EXISTING RECEDED FLOOR PLAN
SCALE 1:100

Notes

This drawing is the copy right of the author and cannot be copied, reproduced, retained or disclosed to any unauthorised person.

This drawing should not be scaled.

Legend

- To Construct
- To Demolish
- As Constructed; To Sanction
- Approved but not constructed; To Sanction

Drawing
**Approved/Existing
Receded Floor Plan**
Scale 1:100 @ A3 Job No 19010 Dwg No 05 Date 10.08.2021

Architect
Henry Attard
Drawn By: K.E. Checked By: M.M.

Project
Minor Amendment
Client
Muscat Sharlo
Site
Mosta

2, Triq iz-Znuber, Attard, ATD 2800 Malta
T (+356) 21422617
M (+356) 99423098
E info@tps.com.mt
W www.tps.com.mt

tps
the Project Studio